


Section 17 Township 31 Range 14W

Well No. #1 Skinner "A"

Company Bishop and Huber

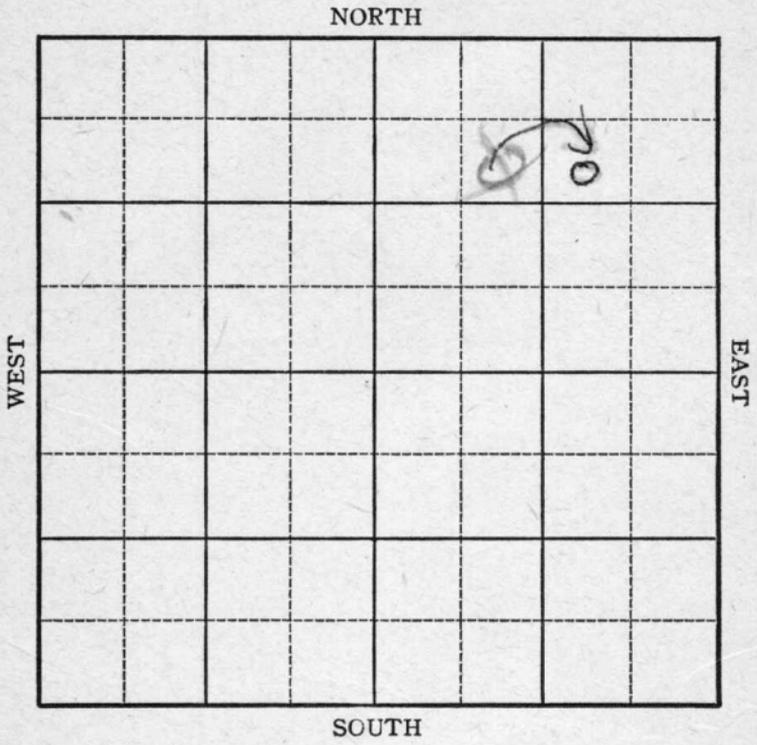



Sec. 17 Twp. 31 R. 14W

Well No. #1 Skinner "A" Farm

Bishop and Huber Company

Skinner

990 Ft. from N. Line


_____ Ft. from S. Line

700 Ft. from E. Line

~~990~~ Ft. from W. Line

SW NE

~~SE NW NE~~

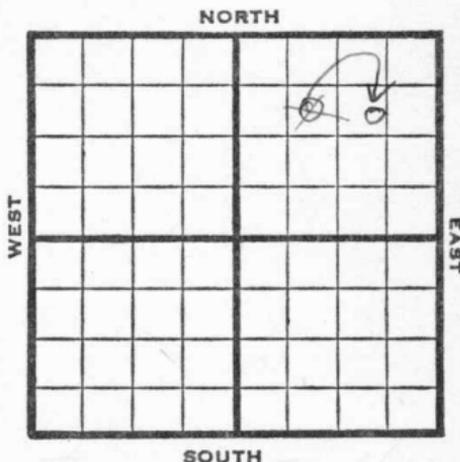

1946

Elev. 1639

REPORT


- 1/23 Location
- 1/31 Derrick.
- 2/7 16" - 70'
- 2/14 Lost hole. Skid 660' East.
16" - 135' Drlg. 645'
- 2/21 10" - 788' Drlg. 2360'
- 2/28 Drlg. 4105'
- 3/7 Viola 4353' T.D. 4382'
5" - 4353' RUST.
- 3/13 Magu 4363
5" @ 4356
5000 acid.
TD 4383
32 M Gas.

COMPLETED

KANSASKansas Pool Name SkinnerMap No. 23 Sec. 17 Twp. 31 R. 14WWell No. 1 Skinner "A"Bishop and Huber CompanyFIRST REPORT Contractor

SE NW NE

SECTION PLAT

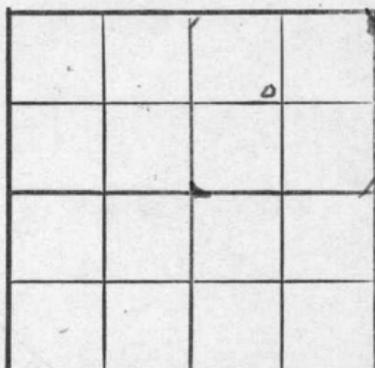990 Ft. from N. Line Ft. from S. Line Ft. from E. Line990 Ft. from W. Line

Barber County

Location XRig up

Drilling and Remarks:

RECORD

Cased in., ft.Sand Gas Oil Total Depth

PRODUCTION

1st 24 hrs. Nat. 1st 24 hrs. after shot Gas Cu. Ft.Dry Hole Abandoned

Date

JAN 23 1946 19S. J. LEWIS Scout

MANSFIELD

17

18

19

20



21

22

23

24

25

26

27

28

Misc. Small Maps

Cards *Sarathy*

Tracing *H*

France Map *[Signature]*

Scarborough Map *[Signature]*

Moody Map *[Signature]*

Geological Dept *[Signature]*

Moody Plat Book

KANSAS Kansas

Pool Name Skinner

Map No. 93 Sec. 17 Twp. 31 R. 14W

Well No. 1 Skinner "A"

Bishop & Huber Company

CORRECTION Contractor

SW NE NE

E/1639

SECTION PLAT

990 Ft. from N. Line

_____ Ft. from S. Line

700 Ft. from E. Line

_____ Ft. from W. Line

			o

Barber County

RECORD

Location _____

Cased _____ in., _____ ft.

Rig up _____

Sand _____

Drilling and Remarks:

Gas _____

Reported in

Oil _____

SE ~~NW~~ NE

Total Depth _____

PRODUCTION

1st 24 hrs. Nat. _____

1st 24 hrs. after shot _____

Gas _____ Cu. Ft.

Dry Hole _____

Abandoned _____

Date

MAR 13 1946 19

S. J. LEWIS Scout

SKINNER
WAL 31 1914

SECTION PLAT

030
700

RECORD

Small Maps	<i>W</i>
Car's	<i>Sarathey</i>
Tracing	<i>7</i>
France Map	<i>7</i>
Scarborough Map	
Pierce Map	<input checked="" type="checkbox"/>
Ceological Dept.	
Plat Book	

Barber County
Location
Reported in

KANSAS

Kansas

Pool Name Skinner

Map No. _____ Sec. 17 Twp. 31 R. 14W

Well No. 1 Skinner "A"

Bishop and Huber Company

COMPLETED

Contractor

SW NE NE

E 1/638

SECTION PLAT

			0

990 Ft. from N. Line

_____ Ft. from S. Line

700 Ft. from E. Line

_____ Ft. from W. Line

Barber County

Location _____

Rig up _____

Drilling and Remarks:

Magu 4350
5' 04356
50000000
32 M Gas

RECORD

Cased _____ in., _____ ft.

Sand _____

Gas _____

Oil _____

Total Depth *4973*

PRODUCTION

1st 24 hrs. Nat. _____

1st 24 hrs. after shot _____

Gas _____ Cu. Ft.

Dry Hole _____

Abandoned _____

Date

MAR 13 1946

19

S. J. LEWIS Scout

Your test report
shows 50 mg N₂

Please let me
have a correction
ticket if you
want in this
other spot
Sam

Misc. Small Maps	<input checked="" type="checkbox"/>
Cards	<input checked="" type="checkbox"/>
Tracing	<input type="checkbox"/>
France Map	<input checked="" type="checkbox"/>
Scarborough Map	<input checked="" type="checkbox"/>
Pierce Map	<input checked="" type="checkbox"/>
Geological Dept.	<input type="checkbox"/>
Pierce Plat Book	<input type="checkbox"/>