


KANSAS Barber

Section 17 Township 31 Range 14W

Well No. 4 Skinner "A"

Company Bishop & Huber

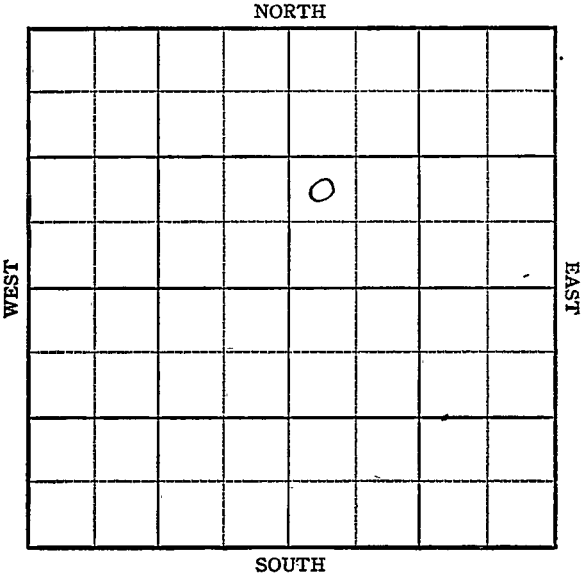

Sec. 17 Twp. 31 R. 14-W

Well No. #4 Skinner "A" Farm

Bishop & Huber Company

Skinner Pool


 Ft. from N. Line

990 Ft. from S. Line

 Ft. from E. Line

,330 Ft. from W. Line

NW SW NE

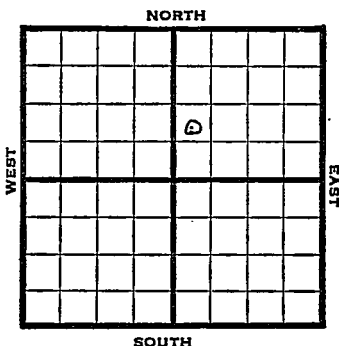

1948 Elev. 1650' REPORT

8/11	Location
8/18	RUR
8/25	8" @ 810' WOC
9/1	Drlg. 2920'
9/8	Drlg. 3910'
9/14	Viola 4371' TD 4400' 5" @ 4392'
9/21	"
9/29	TD 4407'
10/6	1000 acid CO
10/13	"
10/19	"
10/26	Pump 9 bbls oil & 3 W PH - 6 hrs.
11/3	Viola 4377' 5" @ 4392' 1000 acid Pump 345 oil & 5% W Pot. Gr. 41° TD 4407'

COMPLETED

Barber County Kansas State

Map No. _____ Sec. 17 Twp. 31 R. 14W

Well No. 4 Skinner "A"

Bishop & Huber Company

FIRST REPORT

Contractor

NW SW NE

SECTION PLAT

_____ Ft. from N. Line

990 Ft. from S. Line

_____ Ft. from E. Line

330 Ft. from W. Line

Skinner Pool

Remarks:

Location

(90) 371 44
 10 10 0
 2 15 4
 22

Date
AUG 1 1 1948

Scout **S. J. LEWIS**

