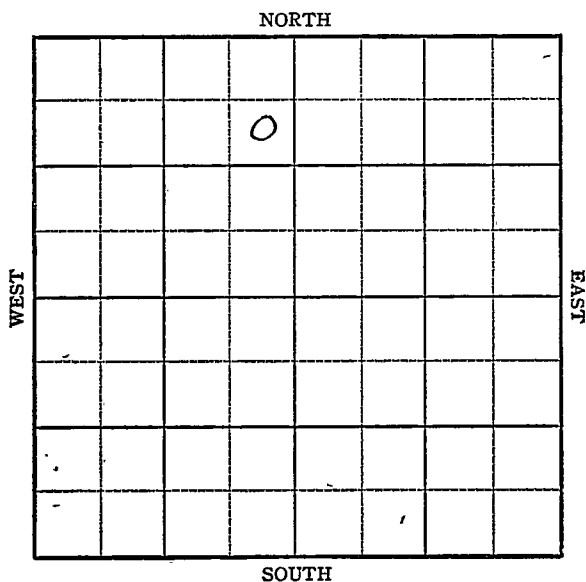


KANSAS Barber

Section 17 Township 31 Range 14WWell No. 2 SkinnerCompany Huber

KANSAS Barber

Sec. 17 Twp. 31 R. 14-W

Well No. #2 Skinner Farm

Huber Company
Skinner


990 Ft. from N. Line

 Ft. from S. Line

330 Ft. from E. Line

 Ft. from W. Line

SE NE NW

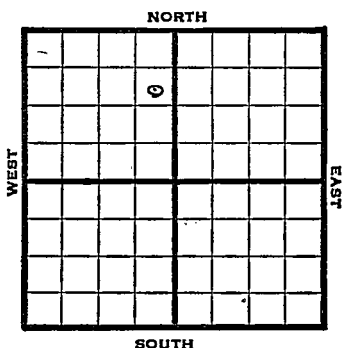

1948 Elev. 1639' REPORT

8/11 RUR
8/18 "
8/25 15" @ 154'
Drlg 1960'

9/1 Drlg. 3690'

9/8 Viola 4334'
TD 4376'
5" @ 4363'

9/14 "

9/21 "

9/29 "

10/6 Viola 4334'
5" @ 4363'
Acid 1000
Depth Pot. 3000 Pot.
Gr. 41°
TD 4381'

COMPLETED

Barber County Kansas StateMap No. _____ Sec. 17 Twp. 31 R. 14WWell No. 2 SkinnerHuber Company**FIRST REPORT**_____
Contractor

SE NE NW

SECTION PLAT

990 Ft. from N. Line

_____ Ft. from S. Line

330 Ft. from E. Line

_____ Ft. from W. Line

Skinner Pool
Remarks:

R U R

Date
AUG 11 1948Scout **S. J. LEWIS**

Map No. 93 Sec. 17 Twp. 31 R. 14^WWell No. 2 Skinner

Huber

Company

COMPLETE

Contractor

SE NE NW

E. 1/68
SECTION PLAT990 Ft. from N. Line

Ft. from S. Line

330 Ft. from E. Line

Ft. from W. Line

	0		

Barber County

Location

Rig up

Drilling and Remarks:

120' to 43345" C 436310000 cu ftDepth to 3000 ft41-1/2

RECORD

Cased _____ in., _____ ft.

Sand _____

Gas _____

Oil / _____Total Depth 4387

PRODUCTION

1st 24 hrs. Nat. _____

1st 24 hrs. after shot _____

Gas _____ Cu. Ft.

Dry Hole _____

Abandoned _____

Date

OCT 6 1948 19 S. I. FWIS Scout