


Section 17 Township 31 Range 14W

Well No. #1 Skinner "H"

Company Huber et al  
Skinner

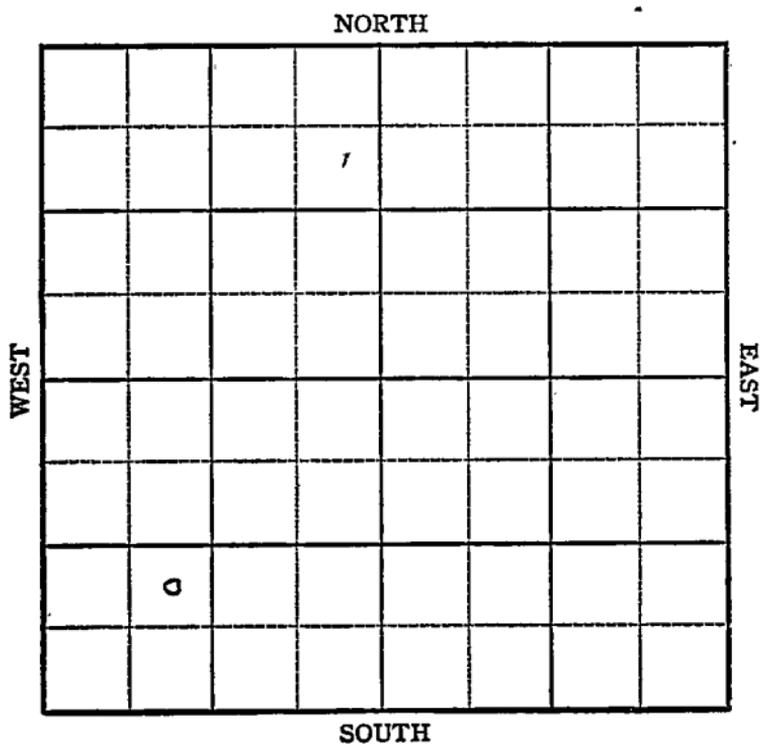

Sec. 17 Twp. 31 R. 14-W

Well No. #1 Skinner "H" Farm

Huber etal. Company

Skinner Pool


           Ft. from N. Line

990 Ft. from S. Line

           Ft. from E. Line

990 Ft. from W. Line

NE SW SW

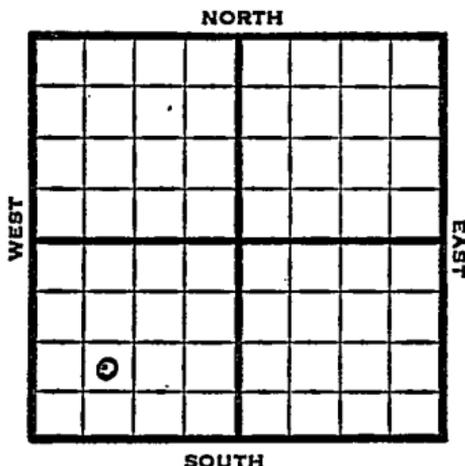

1948 ELEV 1682' REPORT

10/13	10" @ 840'
10/19	Drilg. 1814'
10/26	Drilg. 4161'
11/3	Viola 4392'
	TD 4416
	5" @ 4408'
11/10	1000 acid
11/16	"
11/23	"
11/30	TD 4436'
	1000 acid
12/6	1000 acid
	Flow 20 bbls oil PH - 18 hrs.
12/14	"
12/22	"
12/29	"
1/5	"
1/12	"
1/19	"
1/26	"
2/2	"
2/9	"
2/16	Pump 240 bbls oil 24 hrs.

OVER

1949

2/23 TD 4436'  
Viola 4392'  
5" @ 4408'  
2000 acid  
Pump 140 oil -/ 15% W.Pot  
43<sup>o</sup> Gr.  
Comp

**COMPLETED**

Map No. \_\_\_\_\_ Sec. 17 Twp. 31 R. 14W

Well No. 1 Skinner "H"

Huber etal. Company

FIRST REPORT Contractor

NE SW SW

SECTION PLAT

\_\_\_\_\_ Ft. from N. Line

990 Ft. from S. Line

\_\_\_\_\_ Ft. from E. Line

990 Ft. from W. Line


Barber County

Location \_\_\_\_\_

Rig up \_\_\_\_\_

Drilling and Remarks:

10" @ 840

RECORD

Cased \_\_\_\_\_ in., \_\_\_\_\_ ft.

Sand \_\_\_\_\_

Gas \_\_\_\_\_

Oil \_\_\_\_\_

Total Depth \_\_\_\_\_

PRODUCTION

1st 24 hrs. Nat. \_\_\_\_\_

1st 24 hrs. after shot \_\_\_\_\_

Gas \_\_\_\_\_ Cu. Ft.

Dry Hole \_\_\_\_\_

Abandoned \_\_\_\_\_

Date


OCT 13 1948

S. J. LEWIS Scout


10  
 11  
 12  
 13  
 14

- Misc. Small Maps 10
- Cards Edith
- Tracing J
- France Map J
- Scarborough Map J
- Fierce Map J
- Geological Dept.
- Pierce Plat Book



 

Scout Cards	<i>Edith</i>
Land Small Map	
Land Wall Map	
Tracings	<i>Edith</i>
France Map	✓
Pierce Map	✓
Misc.	