

KANSAS

Barber

Section 17 Township 31 Range 14WWell No. 2 1 Skinner "H"Company Huber

Skinner Pool

NORTH

	0						

WEST

EAST

SOUTH

Sec. 17 Twp. 31 R. 14W ✓

Well No. 1 Skinner "H" Farm

Huber

Company

Skinner Pool


330 Ft. from N. Line

Ft. from S. Line

Ft. from E. Line

990 Ft. from W. Line

NE NW SW

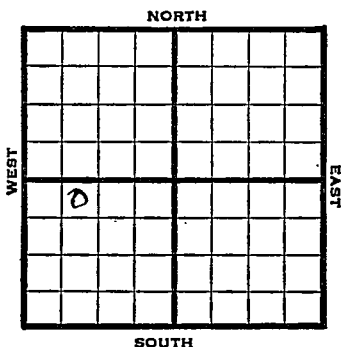

1948

Eli 1697'

R E P O R T

9/1 RUR

9/8 10" @ 840'
Drlg. 2415'

9/14 Lansing 3841'
Drlg. 3984'

9/21 Viola 4410-4440 TD
5" @ 4438'

9/29 "

10/6 "

10/13 TD 4444'
1000 Acid
Flow 27 bbls oil PH - 8 hrs.

10/20 TD 4444'
Viola 4408'
5" @ 4436'
1000 acid
Bomet Pot
1785 Oil / 30% W
41° Gr.
Comp

COMPLETED

Barber County Kansas StateMap No. _____ Sec. 17 Twp. 31 R. 14WWell No. 1 Skinner "H"Huber Company

FIRST REPORT

Contractor


NE NW SW

SECTION PLAT

330 Ft. from N. Line

_____ Ft. from S. Line

_____ Ft. from E. Line

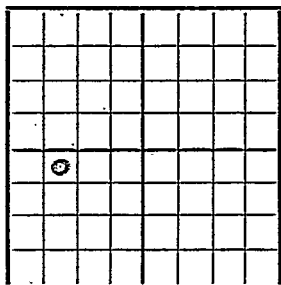990 Ft. from W. LineSkinner Pool

Remarks:

R U R

Date
SEP 1 1948

Scout

S. J. LEWIS

Map No. 93 Sec. 17 Twp. 31 R. 14WWell No. 2 Skinner "H"

Huber

Company

COMPLETE

Contractor

NE NW SW

E11692
SECTION PLAT330 Ft. from N. Line

Ft. from S. Line

Ft. from E. Line

990 Ft. from W. Line

a			

Barber County

Location

Rig up

Drilling and Remarks:

10 1/2" @ 4408
5" @ 4426
10000 ac
Born + Bt
1785 oil + 30% H
4/10/48

RECORD

Cased _____ in., _____ ft.

Sand _____

Gas _____

Oil ☒Total Depth 4444

PRODUCTION

1st 24 hrs. Nat. _____

1st 24 hrs. after shot _____

Gas _____ Cu. Ft.

Dry Hole _____

Abandoned _____

Date

OCT 20 1948 19

S. J. LEWIS Scout