


Section 17 Township 31 Range 14W

Well No. #2 Skinner "B"

Company Coppinger & Southern
Skinner

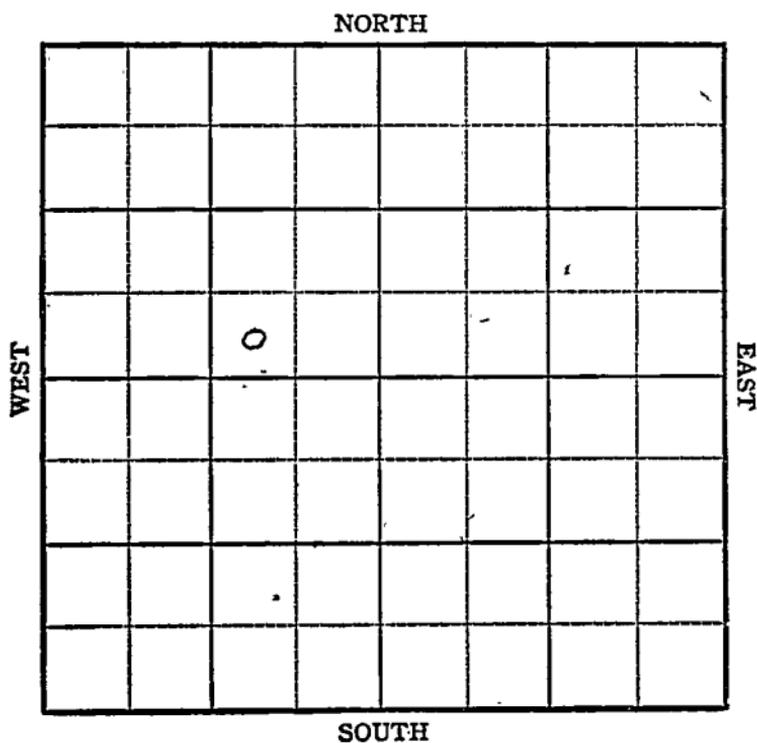

~~KANSAS~~

Barber

Sec. 17 Twp. 31 R. 14-W ✓

Well No. #2 Skinner "B" Farm _____

Coppinger & Southern

Company


Skinner Pool

_____ Ft. from N. Line

330 Ft. from S. Line

990 Ft. from E. Line

_____ Ft. from W. Line

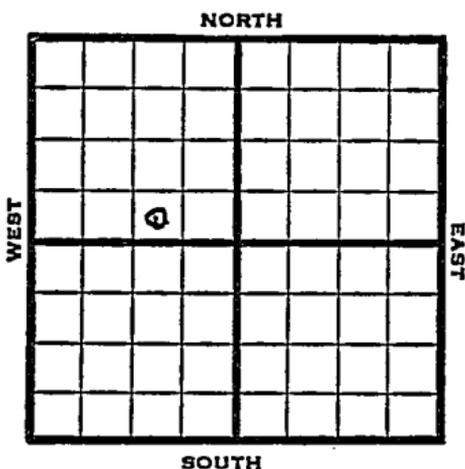

SW SE NW

1948

Eli 1674'

REPORT

10/13

Location

10/19

8" @ 852'

Drlg. 1865'

10/26

Lansing 3781'

Viola 4348'

5" @ 4369'

TD 4390'

11/3

1000 acid

Flow 1/4 bbls oil PH

11/10

"

11/16

"

11/23

"

11/30

"

12/8

TD 4390'

Viola 4348'

5" @ 4369'

1000 acid

Bomb Pot 3000 Oil

40° Gr.

Comp

COMPLETED

Map No. _____ Sec. 17 Twp. 31 R. 14W

Well No. 2 Skinner "B"

Coppinger & Southern Company

FIRST REPORT

Contractor

SW SE NW

SECTION PLAT

_____ Ft. from N. Line

330 Ft. from S. Line

990 Ft. from E. Line

_____ Ft. from W. Line

Barber County

Location X

Rig up _____

Drilling and Remarks:

RECORD

Cased _____ in., _____ ft.

Sand _____

Gas _____

Oil _____

Total Depth _____

PRODUCTION

1st 24 hrs. Nat. _____

1st 24 hrs. after shot _____

Gas _____ Cu. Ft.

Dry Hole _____

Abandoned _____

Date

OCT 13 1948 19

S. J. LEWIS Scout

Map No. 93 Sec. 17 Twp. 31 R. 14WWell No. 2 Skinner "B"Coppinger & Southern Company

COMPLETE

Contractor

SW SE NW

E11674
SECTION PLAT Ft. from N. Line330 Ft. from S. Line990 Ft. from E. Line Ft. from W. Line

	0		

Barber County

Location Rig up

Drilling and Remarks:


RECORD

Cased in., ft.Sand Gas Oil Total Depth 4390

PRODUCTION

1st 24 hrs. Nat. 1st 24 hrs. after shot Gas Cu. Ft.Dry Hole Abandoned

Date

DEC 8 1948 19

S. J. LEWIS Scout