

Well No. 3 Skinner "H"

Company Huber

Skinner Pool

NORTH

WEST

EAST

SOUTH

KANSAS

Barber



Sec. 17 Twp. 31 R. 14W

Well No. #3 Skinner "H" Farm

Huber

Company

Skinner Pool


330' Ft. from N. Line

Ft. from S. Line

330' Ft. from E. Line

Ft. from W. Line

NE SW

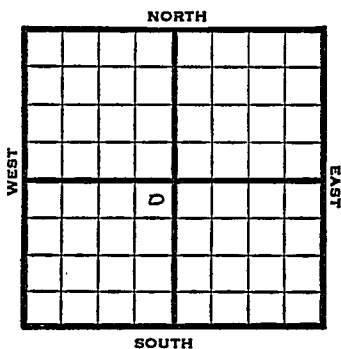

1948

Elev 1661'

R E P O R T

12/8

RUR

12/14

8" @ 840'

Drlg. 2000'

12/22

Drlg. 4092'

12/29

Viola 4367'

TD 4392'

5" @ 4380'

1/5

" "

1/12

"

1/19

"

1/26

3000 acid

Flow 102 bbls

Fluid 8 hr. 25% W

2/2

"

2/9

"

2/16

"

2/23

"

3/2

"

3/8

"

3/16

TD: 4392'

Viola 4367'

5" @ 4380'

1200 acid

Pump 88 Oil / 21% W Pot

41.0 gr.

Comp

COMPLETED

Map No. _____ Sec. 17 Twp. 31 R. 14W

Well No. 3 Skinner "H"

Huber _____ Company

FIRST REPORT _____ Contractor

NE SW

SECTION PLAT

330 Ft. from N. Line

_____ Ft. from S. Line

330 Ft. from E. Line

_____ Ft. from W. Line

		σ	

Barber County

Location _____

Rig up _____

Drilling and Remarks:

R U R

RECORD

Cased _____ in., _____ ft.

Sand _____

Gas _____

Oil _____

Total Depth _____

PRODUCTION

1st 24 hrs. Nat. _____

1st 24 hrs. after shot _____

Gas _____ Cu. Ft.

Dry Hole _____

Abandoned _____

Date _____

DEC 8 1948 19

S. J. LEWIS Scout

Kansas

Map No. 93 Sec. 17 Twp. 31 R. 14WWell No. 3 Skinner "H"Huber et al.

Company

COMPLETE

Contractor

NE SW

E. 1/661


SECTION PLAT

330 Ft. from N. Line

Ft. from S. Line

330 Ft. from E. Line

Ft. from W. Line

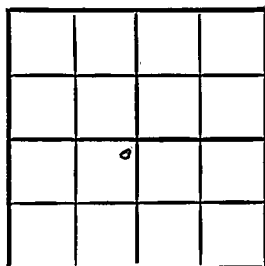

Barber County

Location

Rig up

Drilling and Remarks:

Viola 43675th 43801200 acidPump 180 oil + 21%P.D.5/12/41

RECORD

Cased _____ in., _____ ft.

Sand _____

Gas _____

Oil _____

Total Depth 4392

PRODUCTION

1st 24 hrs. Nat. _____

1st 24 hrs. after shot _____

Gas _____ Cu. Ft.

Dry Hole _____

Abandoned _____

Date

MAR 16 1949

19

S. J. LEWIS

Scout