

Section 17 Township 31 Range 34-W
Well No. #1 Young
Company Woodriver Oil & Ref.

			0				

NORTH

WEST

EAST

SOUTH

KANSAS

Seward



Sec. 17 Twp. 31 R. 34W

Well No. #1 Young Farm

Woodriver Oil & Ref. Company

Hugoton Pool


 Ft. from N. Line

100' Ft. from S. Line

200' Ft. from E. Line

 Ft. from W. Line

SE NW

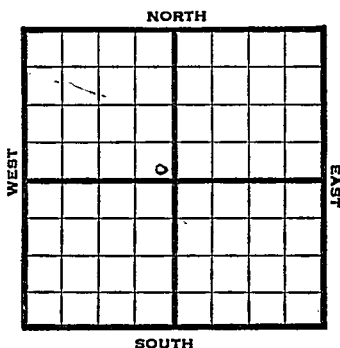

1948	REPORT
	Eli 2825'
6/16	Location
6/23	RUR
6/29	10" @ 425 WOC
7/ 8	TD 2460' 7" @ 2457
7/14	"
7/21	"
7/28	TD 2610' 23000 acid
8/4	158' of 5" perf. liner @ 2610' 6000 acid.
8/11	" "
8/18	" "
8/25	7" @ 2457' TD 2610' 158' of 5" Perf liner @ 2610' 29000 acid 15,273,000 gas 430# R. Pr. Comp
	COMPLETED

Map No. _____ Sec. 17 Twp. 31 R. 34W

Well No. 1 Young

Woodriver Oil & Ref. Company

FIRST REPORT

 Contractor

SE NW

SECTION PLAT

_____ Ft. from N. Line

100 Ft. from S. Line

200 Ft. from E. Line

_____ Ft. from W. Line

Seward County

Location X

Rig up _____

Drilling and Remarks:

RECORD

Cased _____ in., _____ ft.

Sand _____

Gas _____

Oil _____

Total Depth _____

PRODUCTION

1st 24 hrs. Nat. _____

1st 24 hrs. after shot _____

Gas _____ Cu. Ft.

Dry Hole _____

Abandoned _____

Date

JUN 16 1948

19

S. J. LEWIS

Scout

Misc. Small Maps
Cards OK
Tracing ✓
France Map ✓
Scarborough Map 2
Pierce Map ✓
Geological Dept. ✓
Pierce Plat Book ✓

Seward County Kansas State

Map No. Sec. 17 Twp. 31 R. 34W

Well No. 1 Young

Woodriver Oil & Ref. Company

COMPLETE

Contractor

SE NW

E 1,2525-

SECTION PLAT

Ft. from N. Line

100 Ft. from S. Line

200 Ft. from E. Line

Ft. from W. Line

Hugoton Pool

Remarks:

7" @ 2457

X 52610

155' of 5" Prof liner @ 2610

29000 acrod

10,223,000 Gas

420th R/A

Date
AUG 25 1948

Scout S. J. LEWIS

7 5 1 3 5 7


174 65 1





 



Misc. Small Maps	_____
Cards	<i>Edith</i>
Tracing	_____
France Map	_____
Scarborough Map	_____
Pierce Map	_____
Geological Dept.	_____
Pierce Plat Book	_____