


Seward

SECTION 17 TOWNSHIP 31 RANGE 31W **KANSAS**

WELL NO. #1 O.L. Garten Unit

COMPANY Magnolia & Phillips

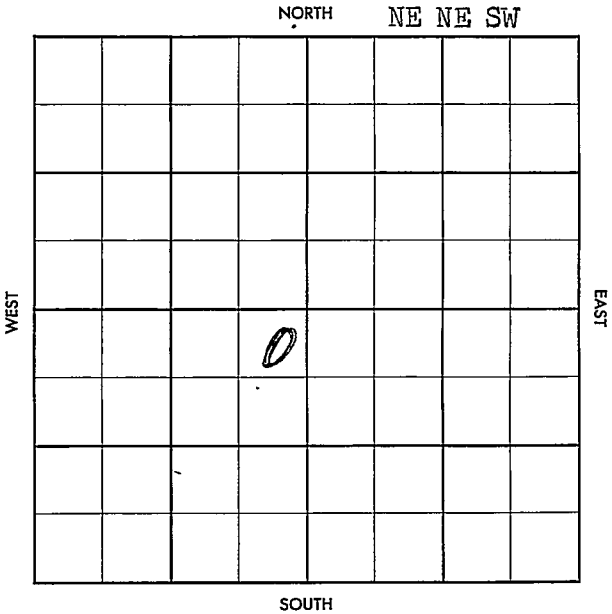

County Seward Elev. _____
 Sec. 17 Twp. 31 Rge. 31W
 Company Magnolia & Phillips
 FarmName O. L. Garten Unit No. 1

TOPS	DEPTH	LOG	DATUM
Anh.			
TP.			
H.			
Tr.			
Dg.			
Bl.			
L.			
K.C.			
B.K.C.			
Ce.			
C.			
M.			
M.			
K.			
Mz.			
Mo.			
V.			
S.			
S.			
A.			
R.			
PE.			
G.			
T.D.			

Loc. in Sec. NE NE SW
 Geol. _____
 Contr. _____
 Pool Thirty-One

FIRST REPORT
 JUN 19 57

Date Comm. _____
 Location Location

~~35~~

Co.
 Lse.
 No.
 Sec.
 T.
 R.

County Seward Elev. 2937 DF
 Sec. 17 Twp. 31 Rgs. 31W
 Company Magnolia & Phillips
 Farm Name C. L. Garten Unit No. 1

TOPS	DEPTH	LOG	DATUM	Loc. in Sec.
Anb.				N ¹ N ¹ SW
Tp <u>Chase 98</u>	<u>2630</u>			
H.	<u>4212</u>			
Tr.				
Dg.				
Bl.				
L.	<u>4730</u>			Geol.
K.C.				
B.K.C.	<u>4881</u>			Contr.
Ce. <u>Marm</u>	<u>4959</u>			
C. <u>Ft set</u>	<u>5112</u>			
M. <u>ce</u>	<u>5726</u>			Pool
M.				
K. <u>Atoka</u>	<u>5229</u>			Thirty-One
Mz. <u>MW</u>	<u>5442</u>			
Mo. <u>MW Id</u>	<u>5476</u>			
V. <u>chest</u>	<u>5527</u>			
S. <u>st Gen</u>	<u>5663</u>			
S.				
A.				
R.				
PE.				
G.				
T.D.	<u>5702</u>			

ABANDONED

AUG 14 '57

Date Comm.

Location JUN. 3 '57 6-27-579 5/8 756/450 MD 2613 JUL 10 '57DST 2620-2763 1hr 60' MDBHP 230/20 MD 3680 JUL 17 '57MD 5174 JUL 17 '57 DST 5432-5515 1hr25' MD N.S. BHP 160/20 DST5408-44 (ST PKR) 1hr packersSTOCK Fishing see FISH5 1/2 @ 2826/750 MICT AUG 14 '57

CO 2785 32/2718-26 \wedge \$
 60 BSW + 556 PB 2712: SQD.
 (PF 2718-26) PF 48/2688
 -2700 no show \wedge no show 15
 ga 29 MCFG + Ld. FRAC 5X5
 \$ Ld + 15 MCFG ~~2001: 1: 57~~ rec Ld
 ga 15 MCFG + 60 BSW in 3 hrs
 retention SQD 2688-2700
 24/2662-~~2688~~ 68 ~~1: 57~~ \wedge FRAC
 5X5 \$ Ld \$ 40 BSW in
 4 hrs no gas

DEQ