

Sec. 17 Twp. 31 R. 33W


Well No. #1 Sully "A" Farm _____

Cities Service Company

Hugoton Pool

NORTH

100' Ft. from N. Line

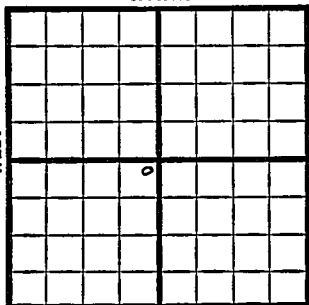

_____ Ft. from S. Line

200' Ft. from E. Line

_____ Ft. from W. Line

SOUTH

NE SW

1949 Elev 2902' REPORT

10/19 Location

10/26 8" @ 600'
 D lg. 2375'

11/1 TD 2760'
 5" @ 2759'

11/9 490 shots 2588-2740
 26000 acid

11/16 9000 acid

11/23 "

11/29 "

12/7 TD 2760'
 5" @ 2759'
 Perf
 35000 acid
 15,500,000 Gas
 410# R Pr.
 Comp

COMPLETED

Map No. _____ Sec. 17 Twp. 31 R. 33W

Well No. 1 Sully "A"

Cities Service _____ Company

Contractor _____

NE SW

FIRST REPORT
SECTION PLAT

100 Ft. from N. Line

_____ Ft. from S. Line

200 Ft. from E. Line

_____ Ft. from W. Line

		o	

Seward County

Location X

Rig up _____

Drilling and Remarks:

RECORD

Cased _____ in., _____ ft.

Sand _____

Gas _____

Oil _____

Total Depth _____

PRODUCTION

1st 24 hrs. Nat. _____

1st 24 hrs. after shot _____

Gas _____ Cu. Ft.

Dry Hole _____

Abandoned _____

Date

OCT 19 1949 19

S. J. LEWIS Scout

Map No. _____ Sec. 17 Twp. 31 R. 33W

Well No. 1 Sally "A"

Cities Service _____ Company

COMPLETE

Contractor

NE SW

L7,2902
SECTION PLAT

100 Ft. from N. Line

	6		

_____ Ft. from S. Line

200 Ft. from E. Line

_____ Ft. from W. Line

Seward County

Location _____

RECORD

Rig up _____

Cased _____ in., _____ ft.

Drilling and Remarks:

Sand _____

Gas _____

Oil _____

Total Depth 2760

5" C2759
Prof.
35000 acid
10,500,000 Gas
*H10 * N/A*

PRODUCTION

1st 24 hrs. Nat. _____

1st 24 hrs. after shot _____

Gas _____ Cu. Ft.

Dry Hole _____

Abandoned _____

Date

DEC 7 1949 19

S. J. LEWIS Scout