

DX 78-1

Sumner KANSAS

Section 17 Township 31 Range 3 W

Well No. # 1 Kerschen

Company South Texas Development Co. (Houston)

NORTH

0							

WEST

EAST

SOUTH

Summer

KANSAS

SEC. 17	TWP. 31	R. 3W
------------	------------	----------

WELL NO. #1 Kerschen FARM

COMPANY South Texas Development Co. (Houston)

CONTRACTOR Peel Bros.


Wildcat.

990 Ft. from N. Line

Ft. from S. Line

Ft. from E. Line

330 Ft. from W. Line

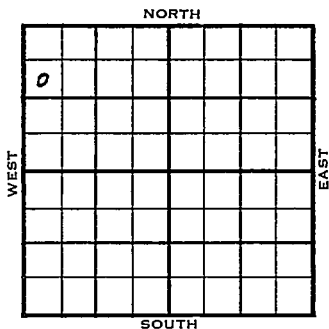


SW NW NW

1954	ELEVATION	REPORT
------	-----------	--------

12/15 R U R

County Sumner State Kansas
 Sec. 17 (Blk. Twp.) 31 (Sur. Rge.) 3W Map No.
 Operator South Texas Development Co. (Houston)
 Well No. 1 Farm Kerschen
 Elev. _____ Location SW NW NW

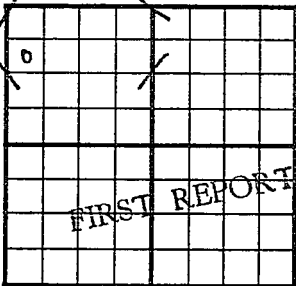

990 Ft. From N Line NW
330 Ft. From W Line Quarter
 Ist. Report DEC 15 1954
 Completion _____
 Remarks Peel Bros - Contr.
 Spudding Date _____

Drig. Data Wildcat
RUR

FABEN GILSTRAP