

Harper


KANSAS
6W

SECTION 17 TOWNSHIP 31S RANGE 6W

WELL NO. #13 Gish

COMPANY Skelly

NORTH E/2 NE SW

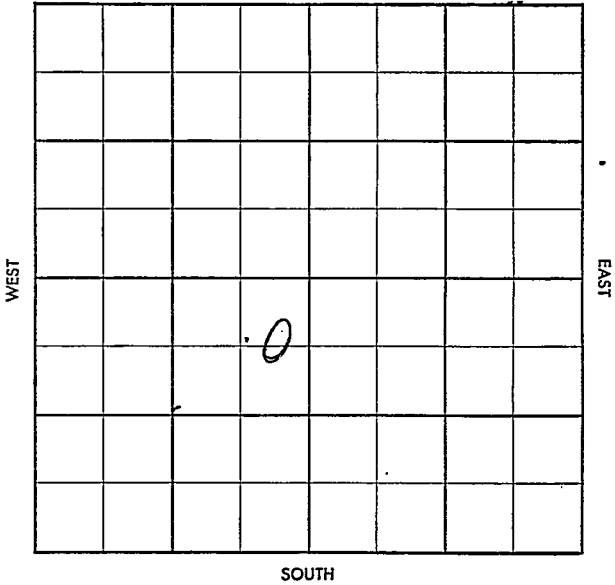


27

S-513-B

County Harper Elev. _____
 Sec. 17 Twp. 31 Rge. 6W
 Company Skelly
 Farm Name Gish No. 13

TOPS	DEPTH	LOG	DATUM
Anh.			
Tp.			
H.			
Tr.			
Dg.			
B.L.			
L.			
K.C.			
B.K.C.			
Ce.			
C.			
M.			
M.			
K.			
Mz.			
Mq.			
V.			
S.			
S.			
A.			
R.			
Pf.			
G.			
T.D.			

Loc. in Sec. _____
E/2 NE SW
 Geol. _____
 Contr. _____
 Pool _____
Gish

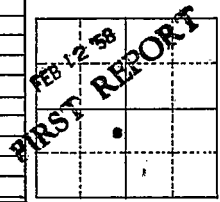

Date Comm. 2/7/58
8# 601/325 WOC

Co.
Lse.
No.
Sec.
T.
R.

Twp. N Pcc' N

Co. X Facet. N

S-513-B

County Harper Elev. 147 feet
 Sec. 17 Twp. 31 Rge. 6W
 Company Skolly
 Farm Name Gish No. 13

TOPS	DEPTH	LOG	DATUM
Anh.			
Tr.			
H.			
Tr.			
Dg.			
B.L.			
L.			
K.C.	<u>37 24</u>	<u>4224</u>	
B.K.C.	<u>Marm</u>	<u>4014</u>	
Ce.			
C.			
M.	<u>Li</u>	<u>4316</u>	
M.			
K.		<u>4557</u>	
Mz.			
Mq.			
V.			
S.	<u>sd</u>	<u>4683 1/2</u>	
S.			
A.			
R.			
Pf.			
G.			
T.D.		<u>4722</u>	

Loc in Sec. E/2 NE SW

Geol.

Contr.

Pool Gish

MAR 19 1958
COMPLETE

Date Comm. 2/7/58

8 1/2" 601/325 WOC FEB 19 58 Ø 3250 DST

4317 -35 60" ga 2740

mc of 155' oil BHP 1650/20" Ø 4500

MAR 5 58 PGT 4684-93 60" 18' gip nec

196' HGCMSW FP 25-65 BHP

580/20 5" 4722/200 #7120B 60

Ø 356 1/2 24/4322 -28 910 thru

CS 9 2.500 mc of 6 hrs 30/

4319-24 910 2" opening 2.

500 mc 2 hrs 5 B D PD

MAR 19 58 F10 2.060 med + 2 Bopd
1" Chk Company of F10 2.165
SITP 1304 SICP 1472
ETP 79 FCP 322

MISS 2319-28