
Harper KANSAS

SECTION 17 TOWNSHIP 31 RANGE ## 6W

WELL NO. #5 A.C. Gish

COMPANY Skelly Oil Co.

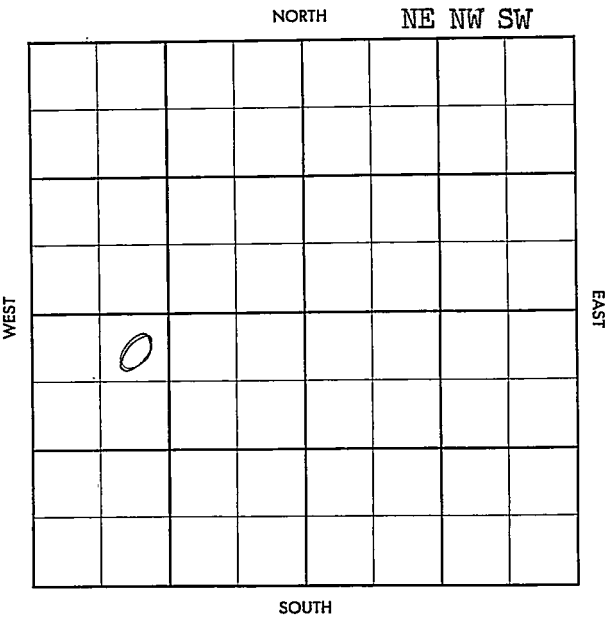

FORM 504-3 SUNRAY

FORM 513 SUNRAY

County Harper Elev.

Sec. 17 Twp. 31 Rge. 6W

Company Skelly Oil Co.

Farm Name A. C. Gish No. 5

TOPS	DEPTH	LOG	DATUM
Anh.			
Tp.			
H.			
Tr.			
Dg.			
B.L.			
L.			
K.C.			
B.K.C.			
Ce.			
C.			
M.			
M.			
K.			
Mz.			
Mq.			
V.			
S.			
S.			
A			
R.			
P€.			
G.			
T.D.			

Loc. in Sec. NE NW SW

Geol.

Contr. Wentworth Tls


Pool Gish

MOST REPORT

APR 24 '57

Date Comm.

Location

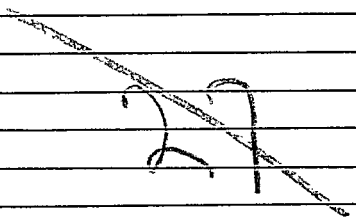

Co. Lse. No. Sec. T. R.

FORM 513 SUNRAY

County Harper Elev. [illegible]

Sec. 17 Twp. 31 Rge. 6W

Company Skelly Oil Co.

Farm Name A. C. Gish No. 5

TOPS	DEPTH	LOG	DATUM
Anh.			
T.P.			
H.			
Tr.			
Dg.			
Bt.			
L.			
K.C.	3728		
B.K.C.			
Ce.			
C.			
M.	4313		
M.			
K.	4560		
Mz.			
Mo.			
V.			
S. Sd	4684		
S.			
A			
R.			
P€.			
G.			
T.D.	4740		

Loc. in Sec. NE NW SW

Geol.

Contr. Wentworth Tls

Pool Gish

COMPLETE

JUN 2 '57

Date Comm.

Location MAY 1 '57 4-26-57 10" @ 6031/325 MAY 2 57 ℗ 2825' MAY 15 57 DST 3859-85 1hr rec 60' O&GCM + 60' HO C&GCM + 60' Sly Mdy oil 30-80 BHP 1075-20" DST 3902-13 1hr rec 30' SOCM FP 15-15 BHP 290/20. ℗ 3971 MAY 22 57 DST 4317-40 1hr G/9" TSTM rec 150.

Co. Lse No. Sec. T. R.

FORM 513-1 SUNRAY

SGCM FP 35-70 BHP
1448/20" DST 4338-65 1hr
rec 120' gas + 220' SO & GCM
+420' SW FP 35-320 BHP
1695 crd 4687-4718 DST
4688-4707 op 20" C/2"
ga 360 MCF Flwd oil 1/15"
est Flow 15 Bopd +1 MIII
CFG BHP 1752/20" FBHP 52/
FP 445-951 TD 4733 MAY 29 '57
5½" 4740/225 JUN 5 '57 CO 4704
44/4688-99 Flw 236
Bo no/w + 39C MCFG
½" ch 24 hrs FCP 280
FTP 320# 1/4 Viso Frac
JUN 12 '57 Amerada BH Bomb
3000 Bopd no/wtr FCP
100# FTP 440#

17-31-6W NE NW SW