
Harper

KANSAS

SECTION 17 TOWNSHIP 31 RANGE 6W

WELL NO. #7 A.C. Gish

COMPANY Skelly Oil Co.

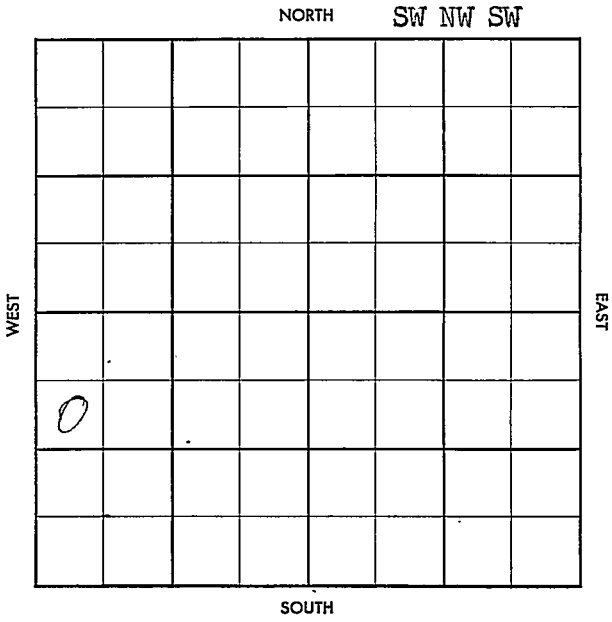

FORM 504-3 SUNRAY

FORM 513 SUNRAY

County Harper Elev.

Sec. 17 Twp. 31 Rge. 6W

Company Skelly Oil Co.

Farm Name A. C. Gish No. 7

TOPS	DEPTH	LOG	DATUM
Anh.			
T.P.			
H.			
Tr.			
Dg.			
B.L.			
L.			
K.C.			
B.K.C.			
Ce.			
C.			
M.			
M.			
K.			
Mz.			
Mo.			
V.			
S.			
S.			
A			
R.			
P€.			
G.			
T.D.			

Loc. in Sec. SW NW SW

Geol.

Contr. Wentworth Tls.

Pool Gish

FIRST REPORT

JUN 12 '57

Date Comm.

M I R T

Co.

Lse.

No.

Sec.

T.

R.

FORM 513 SUNRAY

County Harper Elev. 1494 Co.

Sec. 17 Twp. 31 Rge. 6W

Company Skelly Oil Co.

Farm Name A. C. Gish No. 7

TOPS	DEPTH	LOG	DATUM
Anh.			
Tp.			
H.			
Tr.			
Dg.			
Bl.			
L.			
K.C.	3736		
B.K.C.			
Ce.			
C.			
M.	4313		
M.			
K.			
Mz.			
Mo.			
V.			
S. Sd	4692		
S.			
A			
R.			
P€.			
G.			
T.D.	4743		

Loc. in Sec. SW NW SW

Geol.

Contr. Wentworth Tls. Lse.

Pool Gish

COMPLETE JUL 31 '57

No.

Sec.

T.

R.

Date Comm.

M I R JUN 19 '57 M I R JUN 27 '57

6-15-57 8 5/8 608/325

ℙ 2900 BH - ST DST 3864-85

45" ne 60' GCWM + 120'

0 E GCWM + 60' MSW FP 35-85

BHP 1350/20 ℙ 4130 JUL 10 57

DST 4315-40 1hr ne 40' 50 E GCM

+ 90' 0 E GCWM + 90' Ho E GCWM

BHP 1022/20" DST 4341-54

FORM 513-1 SUNRAY

Ihm rec 60' VSO & GCM + 90' VSO & GCM SW BHP 1320/20" DST 4692-4728 op 46" G/2½" ga 410 MCF/2½" dec. to 310 MCF in 5" si in 5" est 20 Boph BHP 1720/30" 5½ 4743/200 JUL 17 '57 CO 4712. 52/4694-4707 Flw 149 BO no/w + 390 MCFG 4hrs 48/64" ch Flw 257 BO no/w + 310 MCFG in 11hrs 24/64" ch JUL 24 '57 Flw 108 BO no/w + 399 MCFG SICP 590 SITP 590 FCP 520 FTP 420 JUL 31 '57 Amerada BH Bomb Flow 3000 Bopd no/wtr.

17-31-6W SW NW SW