

Harper

Map No. **KANSAS** Sec. *17* Twp. *31* R. *9W*


Well No. *1 M. H. Anthony* Farm
Hood Bros. et al Company

..... Ft. from N. Line

660 Ft. from S. Line

..... Ft. from E. Line

660 Ft. from W. Line

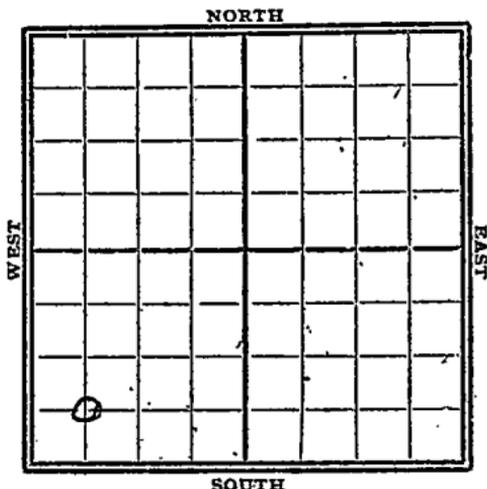

Date	REPORT
<i>1934</i>	
<i>4/11</i>	<i>Material</i>
<i>4/19</i>	<i>13" 162</i>
<i>4/26</i>	<i>— 5/3 — 5/10 —</i>
<i>5/18</i>	<i>— 5/25 —</i>
<i>5/31</i>	<i>57 162</i>
<i>6/7</i>	<i>dy 1835</i>
<i>6/14</i>	<i>" 2387</i>
<i>6/21</i>	<i>" 2975</i>
<i>6/28</i>	<i>7 sq 3485</i>
<i>7/5</i>	<i>Stalcker 3564 Lansing 3750</i>
	<i>dy 3822</i>
<i>7/12</i>	<i>7 sq 4233</i>
<i>7/19</i>	<i>— 7/26 —</i>
<i>8/2</i>	<i>Top Miss L. 4467</i>
<i>8/9</i>	<i>8 1/4 4515 T 7 4521 Rust</i>
<i>8/16</i>	<i>— 8/23 —</i>
<i>8/30</i>	<i>dy 4720 B.L. 4656</i>
<i>9/5</i>	<i>T Viola 4746 S.O.</i>
	<i>T Wilcox 4812 T 7 4816 D T A</i>

ABANDONED

KANSAS

Map No. 33 Sec. 17 Twp. 31 R. 9W

Well No. 1-M. H. Anthony
Wood Bros. etal Company

Contractor

FIRST REPORT

SECTION PLAT

.....Ft. from N. Line

660 Ft. from S. Line

.....Ft. from E. Line

660 Ft. from W. Line

o			

Location.....

Rig up.....

Drilling and Remarks:

Material

RECORD

Cased.....in.,ft.

Sand.....

Gas.....

Oil.....

Total Depth.....

PRODUCTION

1st 24 hrs. Nat.....

1st 24 hrs. after shot.....

Gas.....Cu. Ft.

Dry Hole.....

Abandoned.....

Date

4-11-34 192 *O. Manschuck* Scout

KANSAS

Map No. 33 Sec. 17 Twp. 31 R. 9W

Well No. 1-M. H. Anthony

Wood Bros et al Company

Contractor

ABANDONED

SECTION PLAT

 Ft. from N. Line

660 Ft. from S. Line

 Ft. from E. Line

660 Ft. from W. Line

0			

Location

RECORD

Rig up

Cased in., ft.

Drilling and Remarks:

Sand

Gas

Oil

Total Depth 4816

Top Viola 4746

A. O.

Top Wilcox 4816

NO + FF

PRODUCTION

1st 24 hrs. Nat.

1st 24 hrs. after shot

Gas Cu. Ft.

Dry Hole

Abandoned

Date

9-5-31₁₉

ORVAL MANNSCHRECK
Scout