SIDE ONE

STATE CORPORATION COMMISSION OF KANSAS
OIL & GAS CONSERVATION DIVISION

WELL COMPLETION OR RECOMPLETION FORM
ACO-1 WELL HISTORY

F

DESCRIPTION OF WELL AND LEASE

Operator: license # 5469
name Anadarko Production Company
address P. O. Box 351
Liberal, Kansas 67901
City/State/Zip

Operator Contact Person Paul Gatlin
Phone 316/624-6253

Contractor: license # 5840
name Brandt Drilling Co., Inc.

Wellsite Geologist Joe Blair
Phone (316) 624-2804
PURCHASER Permian

Designate Type of Completion
[X] New Well [ ] Re-Entry [ ] Workover

[X] Oil [ ] SWD [ ] Temp Abd
[ ] Gas [ ] Inj [ ] Delayed Comp.
[ ] Dry [ ] Other (Core, Water Supply etc.)

If OWWO: old well info as follows:
Operator
Well Name
Comp. Date Old Total Depth

API NO. 15 - 033-20,643

County Comanche

150' SW of SE NE Sec 3 Twp 31S Rge 18 [ ] East [X] West
(location)

3194 Ft North from Southeast Corner of Section
766 Ft West from Southeast Corner of Section
(Note: locate well in section plat below)

Lease Name Toothaker A Well# 1

Field Name Mule Creek

Producing Formation Mississippian

Elevation: Ground 2134 KB 2139

Section Plat

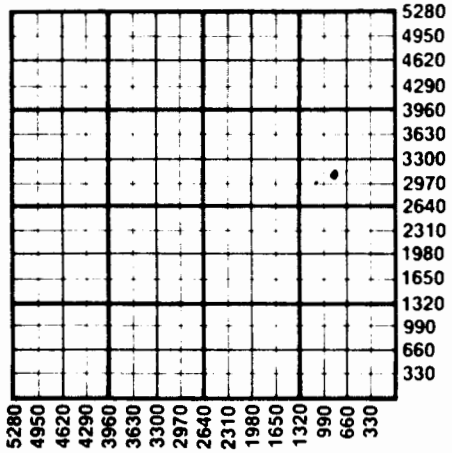

WELL HISTORY

Drilling Method: [X] Mud Rotary [ ] Air Rotary [ ] Cable

7-19-84	8-1-84	8/29/84
Spud Date	Date Reached TD	Completion Date

5120'	5088
Total Depth	PBTD

Amount of Surface Pipe Set and Cemented at 831 feet

Multiple Stage Cementing Collar Used? [ ] Yes [X] No

If Yes, Show Depth Set feet

If alternate 2 completion, cement circulated
from feet depth to w/ SX cmt

Wire line log received

WATER SUPPLY INFORMATION

Source of Water:

Division of Water Resources Permit #

[X] Groundwater 3194 Ft North From Southeast Corner and
(Well) 50 Ft. West From Southeast Corner o
Sec 3 Twp 31S Rge 18 [ ] East [X] West

Water Well on Location.

[ ] Surface Water Ft North From Sourtheast Corner and
(Stream, Pond etc.) Ft West From Southeast Corne
Sec Twp Rge [ ] East [ ] West

[ ] Other (explain)
(purchased from city, R.W.D.#)

Disposition of Produced Water: [ ] Disposal [ ] Repressuring

Docket #

INSTRUCTIONS: This form shall be completed in duplicate and filed with the Kansas Corporation Commission, 200 Colorado Derby Building, Wichita, Kansas 67202, within 90 days after completion or recompletion of any well. Rules 82-3-130 and 82-3-107 apply.

Information on side two of this form will be held confidential for a period of 12 months if requested in writing and submitted with the form. See rule 82-3-107 for confidentiality in excess of 12 months.

One copy of all wireline logs and drillers time log shall be attached with this form. Submit CP-4 form with all plugged wells. Submit CP-111 form with all temporarily abandoned wells.

SEP 1 1984