

Ind. A

STATE CORPORATION COMMISSION OF KANSAS  
OIL & GAS CONSERVATION DIVISION

WELL COMPLETION OR RECOMPLETION FORM  
ACO-1 WELL HISTORY

DESCRIPTION OF WELL AND LEASE

Operator: License # 5050  
Name Hummon Corporation  
Address 400 One Main Place  
Wichita, Ks. 67202

Purchaser Koch Oil Company  
Wichita, KS

Operator Contact Person Wilber Berg  
Phone 316/263-8521

Contractor: License # 5148  
Name Big-H Drilling, Inc.

Wellsite Geologist Tim Pierce  
Phone 316/263-8521

Designate Type of Completion  
 New Well  Re-Entry  Workover  
 Oil  SWD  Temp Abd  
 Gas  Inj  Delayed Comp.  
 Dry  Other (Core, Water Supply etc.)

If OWWO: old well info as follows:  
Operator  
Well Name  
Comp. Date Old Total Depth

WELL HISTORY

Drilling Method:  
 Mud Rotary  Air Rotary  Cable  
8/26/85 9/5/85 9/5/85  
Spud Date Date Reached TD Completion Date  
5176 5140'  
Total Depth PBTD

Amount of Surface Pipe Set and Cemented at 250 feet  
Multiple Stage Cementing Collar Used?  Yes  No  
If yes, show depth set feet  
If alternate 2 completion, cement circulated from feet depth to w/ SX cmt

API NO. 15-033-20-681  
County Comanche  
C. NW SW Sec. 9 Twp. 31 S Rge. 18 W  East  West

1980 Ft North from Southeast Corner of Section  
4620 Ft West from Southeast Corner of Section  
(Note: Locate well in section plat below)


Lease Name Swarner Well # 1

Field Name Wilcox A/FORD

Producing Formation Mississippi

Elevation: Ground 2156 KB 2169

Section Plat

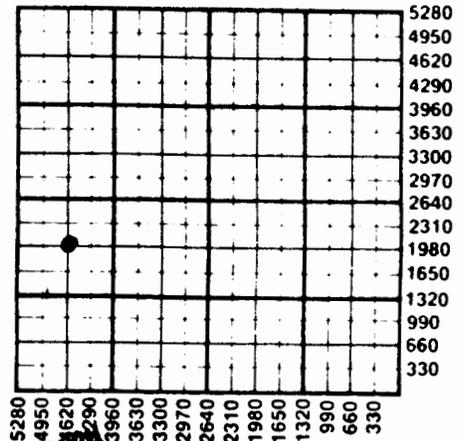

NOV 26 1985

State Geological Survey  
WICHITA BRANCH

WATER SUPPLY INFORMATION

Disposal on Produced Water:  Disposal  Repressuring

Questions on this portion of the ACO-1 call:  
Water Resources Board (913) 296-3717

Source of Water:  
Division of Water Resources Permit #

Groundwater Ft North from Southeast Corner (Well) Ft West from Southeast Corner Sec Twp Rge  East  West

Surface Water Ft North from Southeast Corner (Stream, pond etc) Ft West from Southeast Corner Sec Twp Rge  East  West

Other (explain) J & M Water Hauling (purchased from city, R.W.D. #)

INSTRUCTIONS: This form shall be completed in duplicate and filled with the Kansas Corporation Commission, 200 Colorado Derby Building, Wichita, Kansas 67202, within 90 days after completion or recompletion of any well. Rule 82-3-130 and 82-3-107 apply. Information on side two of this form will be held confidential for a period of 12 months if requested in writing and submitted with the form. See rule 82-3-107 for confidentiality in excess of 12 months. One copy of all wireline logs and drillers time log shall be attached with this form. Submit CP-4 form with