

KANSAS


Form 51-5M-7-39-Palace

Barber

Section 18 Township 31 Range 13-W

Well No. #1 Vanderplas

Company Pryor & Lockhart

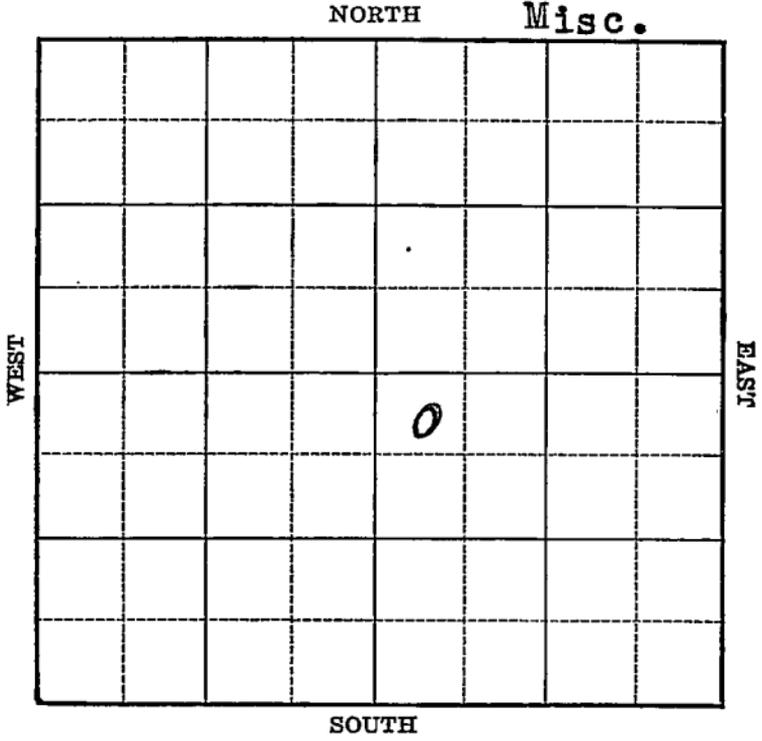

Sec. 18 Twp. 31 R. 13-W

Well No. #1 Vanderplas Farm

Pryor & Lockhart Company

(Misc.)


440 Ft. from N. Line

_____ Ft. from S. Line

_____ Ft. from E. Line

495 Ft. from W. Line

Elv. 1621

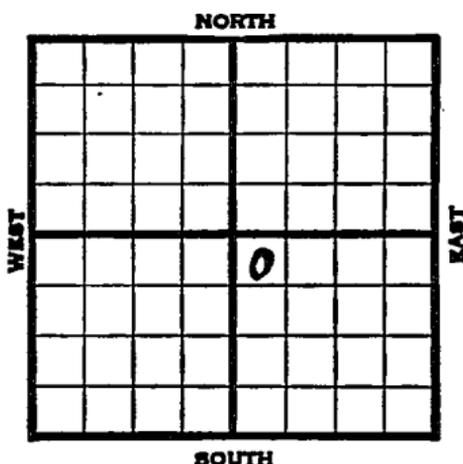

1939	REPORT
12/13	Location
12/21	Rotary.
12/28	"
1940	
1/4	12" - 170'
	SD 1130'
1/11	" "
1/18	Drlg. 2280'
1/25	Ft. Riley 2010' Florence 2020'
	Drlg. 2325'
2/1	Lans. 3765' Fsg. bailer.
2/8	" " " " "
2/15	" " " " "
2/23	" " " " "
2/29	Miss. 4286' Drlg. 4370'
3/6	Arb. 4604'
	T.D. 4620'
	ABANDONED

Map No. 93 Sec. 18 Twp. 31 R. 13W

Well No. 1 Vanderplas

Fryor & Lockhart

Company

Contractor

FIRST REPORT

NW SE

440 Ft. from N. Line

_____ Ft. from S. Line

_____ Ft. from E. Line

495 Ft. from W. Line

SECTION PLAT

		o	

MISCELLANEOUS

Location X

Rig up _____

Drilling and Remarks:

(60 acres)

RECORD

Cased _____ in., _____ ft.

Sand _____

Gas _____

Oil _____

Total Depth _____

PRODUCTION

1st 24 hrs. Nat. _____

1st 24 hrs. after shot _____

Gas _____ Cu. Ft.

Dry Hole _____

Abandoned _____

Date

19

S J. LEWIS

Scout

Map No. 93 Sec. 18 Twp. 31 R. 13W

Well No. 1 Vanderplas

Pryor & Lockhart Company

Contractor

ABANDONED

NW SE

440 Ft. from N. Line

_____ Ft. from S. Line

_____ Ft. from E. Line

495 Ft. from W. Line

SECTION PLAT

		0	

MISCELLANEOUS

Location _____

Rig up _____

Drilling and Remarks:

W + a
1

RECORD

Cased _____ in _____ ft.

Sand Artificial 4604

Gas _____

Oil _____

Total Depth 4620

PRODUCTION

1st 24 hrs. Nat. _____

1st 24 hrs. after shot _____

Gas _____ Cu. Ft.

Dry Hole _____

Abandoned _____

Date

MAR 6 1940 19

S. J. LEWIS Scout