

Barber


KANSAS

FORM 51 5M 6-46 PETROL

Section 18 Township 31 Range 14W

Well No. 2 Oldfather

Company Champlin Ref.

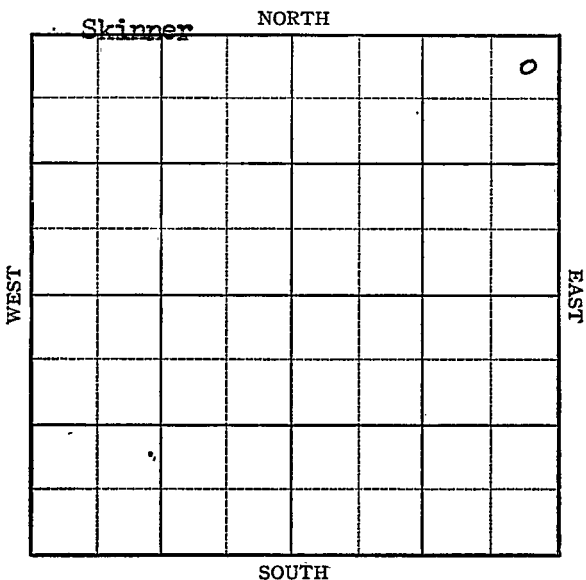

O.W.W.O.

KANSAS

Barber County

Sec. 18 Twp. 31 R. 14W

Well No. 2 Oldfather Farm

Champlin Ref.

Skinner Pool Company


330 Ft. from N. Line

Ft. from S. Line

330

Ft. from E. Line

Ft. from W. Line

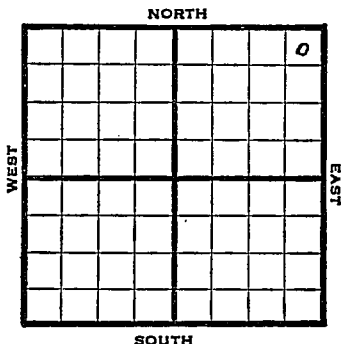

NE/C

O.W.W.O.

1947

Elev. 1653' REPORT

5/7

RUR

5/13

10" @ 450'
Drlg 1699'

5/20

Drlg 3320'

5/27

Drlg. 4300'

6/3

Lansing 3783
Maguoketa 4347
Viola 4389
Simpson 4481
TD 4510
5" @ 4507 RUST

6/10

" "

6/17

" "

6/25

TD 4510'
Maguoketa 4347'
Simpson Sd 4481'
5" @ 4507'
Perf Maquoketa
7500 Acid
3 1/2 M Gas
Complete

OVER

COMPLETED

O.W.W.O.

1950

9/13 Maq 4347

Viola 4389

Simp 4481

OTD 4510

5" @ 4510

Sq perf 4346-56. Reperf 33/4409-20

500 A S/15 BO 10 bwpd

1000 A S/10 bo 10 bwpd 1000 A

S/9 bo 9 bwpd Perf. 4358-82 No inc.

Perf 4241-54 1000 A No inc. SP 4200

24/3860-74 S/2 bwph

D&A

FIRST REPORT

ABANDONED

Map No. 193 Sec. 18 Twp. 31 R. 14WWell No. 2 OldfatherChamplin Ref. CompanyFIRST REPORT Contractor

NE/C

SECTION PLAT

			0

330 Ft. from N. Line Ft. from S. Line330 Ft. from E. Line Ft. from W. Line

Barber County

Location Rig up

Drilling and Remarks:

R U R

RECORD

Cased in., ft.Sand Gas Oil Total Depth

PRODUCTION

1st 24 hrs. Nat. 1st 24 hrs. after shot Gas Cu. Ft.Dry Hole Abandoned

Date

MAY 14 1947

19

S. J. LEWIS

Scout

Misc. Small Maps

Cards

Tracing

France Map

Scarborough Map

Pierce Map

Geological Dept.

Pierce' Plat Book

Map No. 93 Sec. 18 Twp. 31 R. 14W

Well No. 2 Oldfather

Champlin Ref. Company

COMPLETE

Contractor

NE/C


F11653
SECTION PLAT

330 Ft. from N. Line

 Ft. from S. Line

330 Ft. from E. Line

 Ft. from W. Line

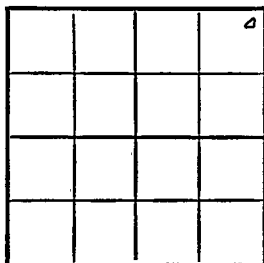

Barber County

Location

Rig up

Drilling and Remarks:

Magueta 4347
Simp. Sol 4481
5' @ 4507
Red Magiv.
7500 feet
3 1/2 M Gas.

RECORD

Cased in, ft.

Sand

Gas

Oil

Total Depth 4510

PRODUCTION

1st 24 hrs. Nat.

1st 24 hrs. after shot

Gas Cu. Ft.

Dry Hole

Abandoned

Date

JUN 25 1947 19 S. J. LEWIS Scout

RECEIVED

Misc Small Maps	☒
Cards	☒
Tracing	☒
France Map	☒
Scarborough Map	☒
Pierce Map	☒
Geological Dept.	☐
Pierce Plat Book	☐

County Barber State KansasSec. 18 (Blk. Twp.) 31 (Sur. Rge.) 14W Map No.Operator Champlin Ref.Well No. 2 Farm OldfatherElev. 1651 Location NE NE NE

						0

330 Ft. From N Line NE330 Ft. From E Line Quarter1st. Report SEP 13 1950Completion SEP 13 1950Remarks OW YVO

Spudding Date

Drilg. Data D & A TD 4510

Maq. 4347 Viola 4389 Simp. 4481 OTD 4510

5" @ 4510 sq. perf. 4346-56 Reperf.

33/ 4409-20 500 A S/ 15 bo 10 bwpd

1000 A S/ 10 bo 10 bwpd 1000 A

S/ 9 bo 9 bwpd Perf. 4358-82 No inc.

Perf. 4241-54 1000 A No inc. SP 4200

24/ 3860-74 S/ 2 bwph

D & A

SEP 15 1950

Scout Cards	7
Land Small Map	
Land Wall Map	3
Tracings	
France Map	
Pierce Map	
MISC.	

Dirg. Data