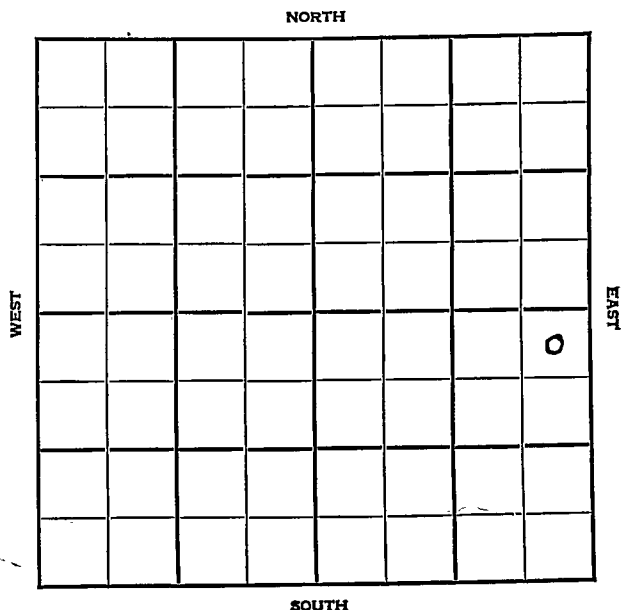


O.W.W.O.

KANSAS

Barber

Section 18 Township 31 Range 14-WWell No. #1 OldfatherCompany Coppinger & Musgrove

Sec. 18 Twp. 31 R. 14W

Well No. #1 Oldfather Farm

Coppinger & Musgrove Company

Skinner Pool


330' Ft. from N. Line

Ft. from S. Line

330' Ft. from E. Line

Ft. from W. Line

NE SE

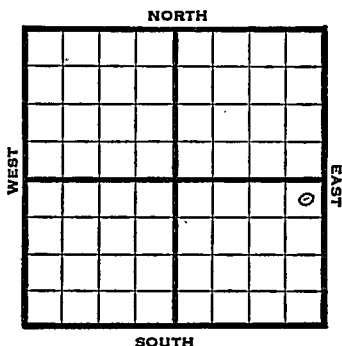

1948	Elev. 1689'	REPORT
5/12	Derrick	O.W.W.C.
5/19	RUR	
5/26	8" @ 825'	
	Drlg. 2025'	
6/1	Drlg. 3195'	
6/9	Drlg. 4231'	
6/16	Miss 4322'	
	Nagwoketa 4395'	
	Viola 4437'	
	5" @ 4428'	
	TD 4446'	
6/23	HFO - 5 hrs.	
6/29	"	
7/8	"	
7/14	"	
7/21	"	
7/28	"	
8/4	19,769,000 gas.	
8/11	Viola 4437'	
	5" @ 4428'	
	TD 4446'	
	Gas 19,769,000 sso	
	COMPLETED	OVER

1950

O.W.W.O.

5/31 Miss 4322'
Viola 4437'
OTD 4446'
5" @ 4428 was gas well in Viola
SP 4328' PRF 48/4294-4310
Test 41,000,000 CFGPD
Heebler 3640' Douglas 3710'
KC 3810'

FIRST REPORT


COMPLETED

1950

6/7 Miss 4322'
Viola 4437'
OTD 4446'
5" @ 4428'
Was gas well in Viola
Set plug @ 4328'
Heeb 3640'
KC 3810'
41,000,000 cu ft gas pr day

COMPLETED

Map No. _____ Sec. 18 Twp. 31 R. 14W

Well No. 1 Oldfather

Coppinger & Musgrove Company

FIRST REPORT

Contractor

NE SE

SECTION PLAT

330 Ft. from N. Line

_____ Ft. from S. Line

330 Ft. from E. Line

_____ Ft. from W. Line

Barber County

Location _____

Rig up _____

Drilling and Remarks:

Derrick

RECORD

Cased _____ in., _____ ft.

Sand _____

Gas _____

Oil _____

Total Depth _____

PRODUCTION

1st 24 hrs. Nat. _____

1st 24 hrs. after shot _____

Gas _____ Cu. Ft.

Dry Hole _____

Abandoned _____

Date

MAY 12 1948 19 S. J. LEWIS Scout

Misc. Small Maps _____
Cards _____
Tracing _____
France Map _____
Scarborough Map _____
Pierce Map _____
Co. & Civil Dept. _____
P. & Flat Book _____

Barber County Kansas State

Map No. 93 Sec. 18 Twp. 31 R. 14^W

Well No. 1 Oldfather

Coppinger & Musgrove Company

COMPLETE Contractor

NE SE

E 11689
SECTION PLAT

330 Ft. from N. Line

 Ft. from S. Line

330 Ft. from E. Line

 Ft. from W. Line

Skinner Pool

Remarks:

Vista 4437

5' @ 4428

YTD 4446

19,769.000

Date
AUG 11 1948

Scout S. J. LEWIS





Misc. Small Maps

Cards

Tracing

France Map

Scarborough Map

Pierce Map

Geological Dept.

Pierce Plot Book

O.W.W.O.

Map No. _____ Sec. 18 _____ Twp. 31 _____ R. 14W _____

Well No. 1 Oldfather _____

Coppenger & Southern _____ Company

_____ Contractor

NE NE SE

E1.1689

SECTION PLAT

330 _____ Ft. from N. Line

_____ Ft. from S. Line

330 _____ Ft. from E. Line

_____ Ft. from W. Line

COMPLETE			
			o
FIRST REPORT			

Barber

QWWO

Location _____

Rig up _____

Drilling and Remarks:

Miss 4322

Viola 4437

OT.D. 4446

5" @ 4428

was gas well
in ViolaSP4328 PRF.48/
4294-4310

RECORD

Cased _____ in., _____ ft.

Sand _____

Gas _____

Oil _____

Total Depth _____

PRODUCTION

1st 24 hrs. Nat. _____

1st 24 hrs. after shot _____

Gas _____ Cu. Ft.

Dry Hole _____

Abandoned _____

Tested 41000000 CFGPD Heebler 3640

Date Douglas 3710 Kansas City 3810

Complete

MAY 31 1950 19 J. E. TYRA Scout


Y. 300

11

1950

(1950)

1950

 

1950

1950

1950

Scout Cards
Land Small Map
Land Wall Map
Tracings
France Map
Pierce Map
Misc.

Kansas

Map No. _____ Sec. 18 Twp. 31 R. 14W

Well No. 1 Oldfather

Coppenger & Southern Company

NE NE SE Contractor

E1.1689

SECTION PLAT


330 Ft. from N. Line

_____ Ft. from S. Line

330 Ft. from E. Line

_____ Ft. from W. Line

OWWO

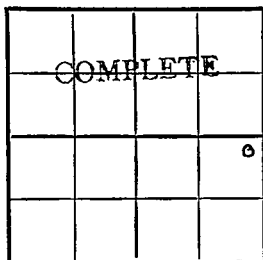

Barber

Location _____

Rig up _____

Drilling and Remarks:

Miss 4322

Viola 4437

Old T.D. 4446

5' @ 4428

was gas well in

Viola -

Set plug @ 4328

(over)

Date

RECORD

Cased _____ in., _____ ft.

Sand _____

Gas _____

Oil _____

Total Depth _____

PRODUCTION

1st 24 hrs. Nat. _____

1st 24 hrs. after shot _____

Gas _____ Cu. Ft.

Dry Hole _____

Abandoned _____

JUN 7 1956 19 J. E. TYRA Scout

Hub 3640
KC. 3810

perf 48/4294-4310

41,000,000 Cu ft gas
per day.

Scout Cards	✓
Land Small Map	✓
Land Wall Map	✓
Tracings	✓
France Map	✓
Pierce Map	✓
Misc.	✓

JUN 15 1953