

DX 78-1 Barber

KANSAS

Section 18 Township 31 Range 11W

Well No. #1 Shaft

Company Monsanto & Sierra

NORTH

	0						
				7			
				7			

WEST

EAST

SOUTH

SEC.	TWP.	R.
18	31	14W

WELL NO.

#1 Shaft

FARM

COMPANY

Monsanto & Sierra

CONTRACTOR

Sierra


Skinner

_____ FT. FROM N. LINE

_____ FT. FROM S. LINE

_____ FT. FROM E. LINE

_____ FT. FROM W. LINE

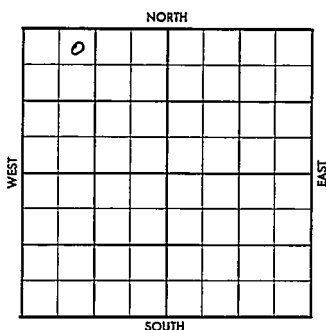

NE NW NW

	ELEVATION	REPORT
1956	1658'	
6-27	Location	
8-15	Comm. 7-20-56 8 5/8" @ 823 w/500 DST 3677-3723 op 35 min. rec. 85' MSW, BHP 1325/35". DST 3838-70 op 45 min. rec. 35' WM, BHP 40/15" DST 4021-45 op 1 hr., 210' OCM, BHP 1470/20". DST 4245-87 op 1 hr., rec. 35' mud, DST 4438-45 op 1 hr., rec. 30' SOCM, BHP 0#. DST 4438-45 op 1 hr., rec. 15' SOCM BHP 150/30". DST 4492-4516 op 30 min. rec. 12' mud, BHP 360/20". DST 4555-70 op 1 hr., 690' GCSW, BHP 1590/30" D & A Anh. 1040'; Tark 2893'; Tp. 3203'; Hb. 3634'; Tr. 3651'; Dg. 3677'; L. 3809'; Massey 4257'; M. 4319'; V. 4437'; S. 4558'; A. 4673'; TD 4715'	
	ABANDONED	

County

Barber

Elev.

Sec.

18

Twp.

31

Rge.

11W

Company

Monnanto & Sierra

FarmName

Shaft

No.

1

TOPS	DEPTH	LOG	DATUM
Anh.			
Tr.			
H.			
Tr.			
Dg.			
Bl.			
L.			
K.C.			
B.K.C.			
Ce.			
C.			
M.			
M.			
K.			
Mz.			
Mo.			
V.			
S.			
S.			
A.			
R.			
Pe.			
G.			
T.D.			

Loc. in Sec.

NE NW NW

Geol.

Contr.

Sierra

Pool

Skinner

0

JUN 27 '55

FIRST REPORT

Date Comm.

Location

26

VTZ

County Barber Elev. 1000
 Sec. 18 Twp. 31 Rge. 11W
 Company Monsanto & Sierra
 Farm Name Shelf No. 1

TOPS	DEPTH	LOG	DATUM	Loc. in Sec.
Anb.	1040			NE NW 10W
Tp.	2893			
H.	3203			
Tr.	3634			
Dg.	3651			
Bl.	3677			
L.	3809			Geol.
M.	4257			Contr.
B.K.C.				Sierra
Ce.				
C.				
M.	4319			
M.				Pool
K.				Skinner
Mz.				
Mo.				
V.	4437			
S.	4558			
S.				
A.	4673			
R.				
Pe.				
G.				
TD.	4715			

ABANDONED

Date Comm. AUG 15 '56

Location JUL 3 '56 JUL 11 " JUL 18 '56 JUL ...

7-20-56 878 @ 23/500
 ID 2190 AUG 1 '56 DST 3677-3723
 35" rec 85' MSW BHP 1325/35"
 DST 3838-70 45" .35' WM BHP
 40/15" ID 3930 AUG 8 '56 DST
 4021-45 or 1hr 210' OCM
 BHP 1470/20 DST 4245-86 1hr.
 35' Md BHP? - DST 4438-45

1hr 30' 50CM BHP 0 DST
4438-45 1hr rec 15' 50CM
BHP 150/30" DST 4492-4516
30" rec 12' MD BHP 360/20
DST 4555-70 AUG 15 '56 cr 1hr
690' QCSW BHP 1590/30"

DEA