


Section 16 Township 31 Range 35-W

Well No. #1 Hinshaw Est.

Company Magnolia

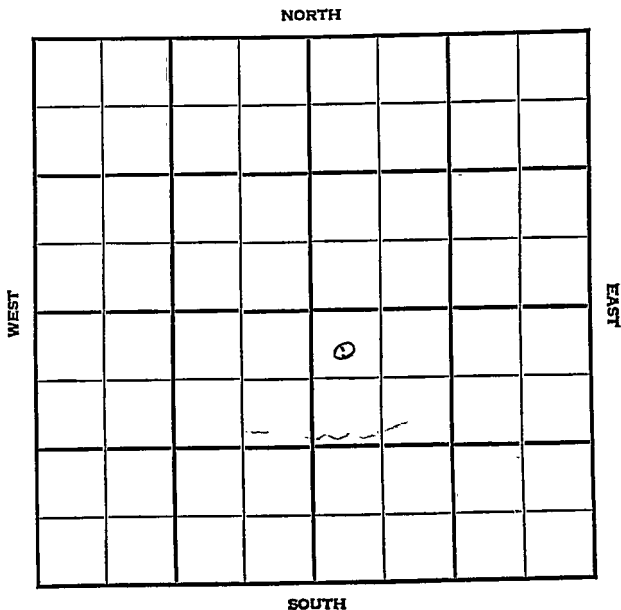

Map No. _____ Sec. 18 Twp. 31 R. 35W

Well No. 1 Hinshaw Est.

Magnolia Company

FIRST REPORT Contractor

NW SE

SECTION PLAT

330 Ft. from N. Line

_____ Ft. from S. Line

_____ Ft. from E. Line

330 Ft. from W. Line

		△	

Stevens County

Location _____

Rig up _____

Drilling and Remarks:

10" @ 640 WOC

RECORD

Cased _____ in., _____ ft.

Sand _____

Gas _____

Oil _____

Total Depth _____

PRODUCTION

1st 24 hrs. Nat. _____

1st 24 hrs. after shot _____

Gas _____ Cu. Ft.

Dry Hole _____

Abandoned _____

Date

JUL 8 1948 19

S. J. LEWIS Scout

Stevens County Kansas State

Map No. _____ Sec. 18 Twp. 31 R. 35W

Well No. 1 Hinshaw Est.

Magnolia Company

COMPLETE

Contractor

NW SE

E1,2011
SECTION PLAT

330 Ft. from N. Line

_____ Ft. from S. Line

_____ Ft. from E. Line

330 Ft. from W. Line

Hugoton Pool

Remarks:

7" @ 2787

7" @ 2788

Perf.

21,000 acid

20,450,000 gal

410 # R₂

Date 4 1948

Scout S. J. LEWIS