


Section 18 Township 31 Range 37 WWell No. # 1 GerrondCompany Hugoton Prod.

NORTH

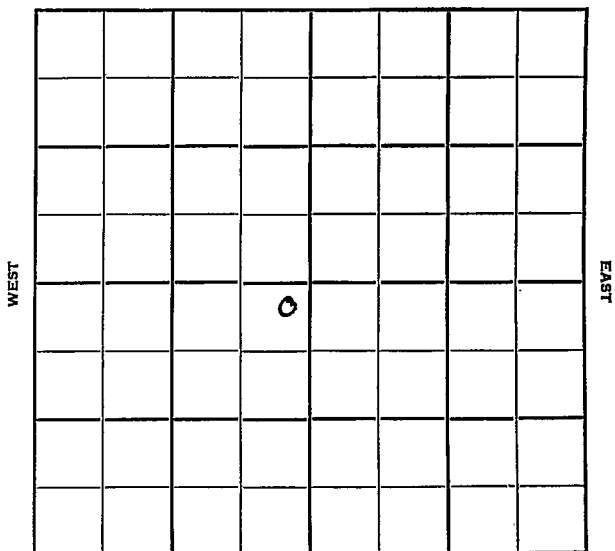

SOUTH

Stevens KANSAS

Sec. 18 Twp. 31 R. 37 W

Well No. # 1 Gerrond Farm

Hugoton Prod. Company

Moran Drlg. Contractor

Hugoton Pool


200 Ft. from N. Line

 Ft. from S. Line

200 Ft. from E. Line

 Ft. from W. Line

NE SW

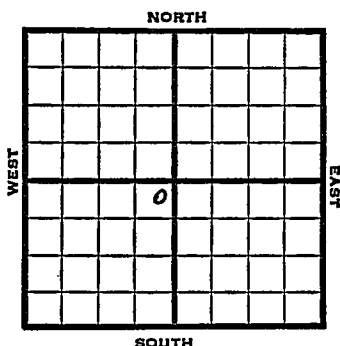

1951 Elev. 3111' REPORT

12/12 Spud 12-10-51
Drlg. 277'

1952
1/23 Spud 12-10-51
Gas Well TD 2664'
Kri 2450 Win. 2517 Ft. Riley 2576
Comp. 41,954,000 gas

COMPLETED

County Stevens State Kansas
 Sec. 18 (Blk. Twp.) 31 (Sur. Rge.) 37W Map No. _____
 Operator Hugoton Prod.
 Well No. 1 Farm Gerrond
 Elev. _____ Location NE SW

FIRST REPORT

0

200 Ft. From N Line SW
200 Ft. From E Line Quarter
 Ist. Report DEC 1 2 1951
 Completion _____
 Remarks _____
Moran Drilg. - Contr.
 Spudding Date 12-10-51

Drlg. Data Hugoton Pool
drlg. 277

J. E. TYRA

County Stevens State Kansas
 Sec. 18 (Blk. Twp.) 31 (Sur. Rge.) 37W Map No. _____
 Operator Hugoton Prod.
 Well No. 1 Farm Gerrond
 Elev. 3111 Location NE SW

COMPLETE

0

200 Ft. From N Line SW
 200 Ft. From E Line Quarter
 Ist. Report _____
 Completion JAN 23 1952
 Remarks Hugoton Pool
Moran Drlg. - Contr.
 Spudding Date 12-10-51

Drlg. Data Gas well TD 2664
10" @ 487 7" @ 2425 TD 2664
Kri. 2450 Win. 2517 Ft. Riley 2576
Comp. 41,954,000 gas

J. G. McGEHEE