

KANSAS
Seward

Seward

Section 18 Township 31 Range 34W

Well No. 1 W. Griffith

Company United Prod.

Hugoton Pool
NORTH

NORTH

WEST

EAST

SOUTH

Sec. 18 Twp. 31 R. 34W ✓

Well No. 1 W. Griffith Farm

United Prod. Company
Hugoton Pool


100 Ft. from N. Line

 Ft. from S. Line

 Ft. from E. Line

100 Ft. from W. Line

NW SE

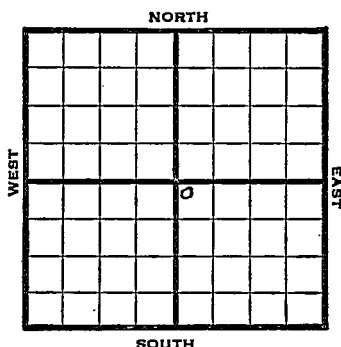

1948 Elev. 2923' REPORT

8/25 RUR

9/1 10" @ 563'
Drlg. 2060'

9/8 TD 2546'
7" @ 2544'

9/14 TD 2716-179' of 5" perf liner @ 2716

9/21 Acid 14,000

9/29 "

10/6 7" @ 2544'
179' of 5" Perf liner @ 2716
Acid 14,000
Gas 17,800,000
R. Pr. 417#
TD 2716'

COMPLETED

Seward County Kansas State
 Map No. _____ Sec. 18 Twp. 31 R. 34W

Well No. 1 W. Griffith

United Prod. Company

FIRST REPORT Contractor

NW SE

SECTION PLAT

100 Ft. from N. Line

_____ Ft. from S. Line

_____ Ft. from E. Line

100 Ft. from W. Line

				o			

Hugoton Pool

Remarks:

R U R

Date
AUG 25 1948

Scout S. J. LEWIS

Map No. _____ Sec. 18 Twp. 31 R. 34^W

Well No. 1 W. Griffith

_____ United Prod. _____ Company

_____ **COMPLETE** _____ Contractor

NW SE


E1, 2923
SECTION PLAT

100 Ft. from N. Line

_____ Ft. from S. Line

_____ Ft. from E. Line

100 Ft. from W. Line

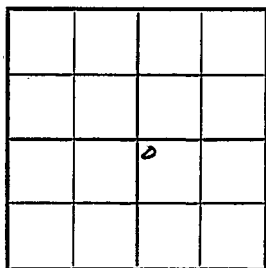

Seward County

Location _____

Rig up _____

Drilling and Remarks:

2" @ 2544

17.9' of 5" Dry liner

@ 2716

14000 acs C

17,800,000 lbs

417# R.P.

RECORD

Cased _____ in., _____ ft.

Sand _____

Gas _____

Oil _____

Total Depth 2716

PRODUCTION

1st 24 hrs. Nat. _____

1st 24 hrs. after shot _____

Gas _____ Cu. Ft.

Dry Hole _____

Abandoned _____

Date

OCT 6 1948

19

S. I. LEWIS

Scout