


Section 18 Township 31 Range 31W

Well No. #1 Ellis

Company Helmerich & Payne Inc.

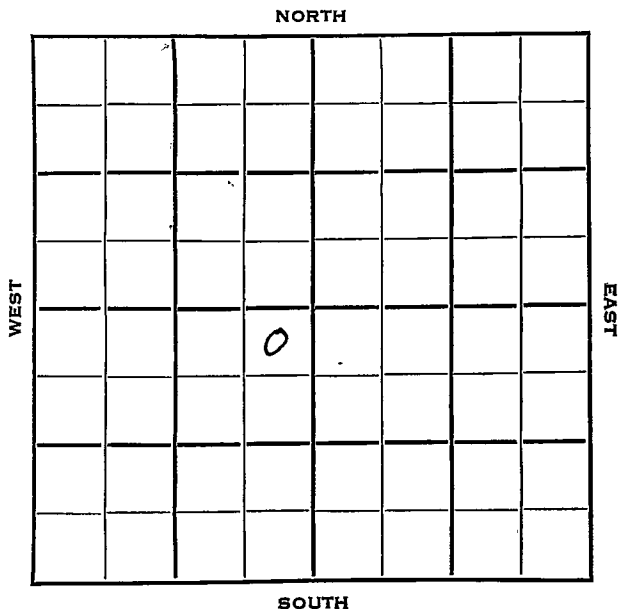

Seward

KANSAS

SEC.	TWP.	R.
18	31	31W ✓

WELL NO.

1 Ellis

FARM

COMPANY

Helmerich &amp; Payne, Inc.

CONTRACTOR


Wildcat

330 Ft. from N. Line

Ft. from S. Line

330 Ft. from E. Line

Ft. from W. Line

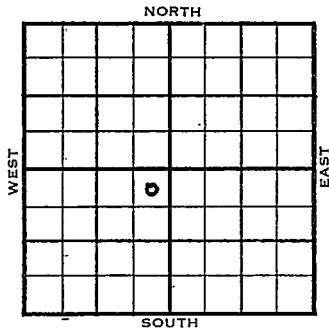

NE NE SW

Ohio Farmout

1953

ELEVATION

2846'

REPORT

9/23

Spud 9-22-53

Miss Test

9/30

13" @ 652 HoI 2591 Her 2648  
 Kr 2670' Win 2745' Tow 2802'  
 Ft. Riley 2848'

10/7

DST 4359'-4419' 1 hr, 2600' SW, 1185#  
 Drlg.

10/14

Heeb 4177, Land 4316, B KC 4859, Marm  
 4910

DST 4544-80 1 hr, 40' M 1410#

DST 4620'-77' 1 hr, 40' M 980#

DST 4772'-4810' 1 hr, 1740' sw 1550#

DST 5213'-40' 1 hr, 14' M.

10/21

DST 5407'-81' 1 hr, 1 1/2 M gas, 405'  
 gcm, 1640#

DST 5481'-5505' 1 hr, 40' M 190#

Miss 5525,

DST 5768'-80' 1 hr, 55' M 1210#

Morrow 5410, Chester 5560, St. Gen.  
 5664,

RTD 5780

10/28

5" @ 5547'

OVER

1953  
11/18

Spud 9-22-53 Gas well TD 5780'  
13" @ 652 Hol. 2591 Her. 2648  
Kri. 2670 Win. 2745' Tow. 2802  
Ft. Riley 2848  
DST 4359-4419 open 1 hr rec 2600' SW  
1485# Heeb 4177 Lans 4316  
B KC 4859 Marm 4910'  
DST 4544-80 open 1 hr rec 40' mud  
1410#  
DST 4620-77 open 1 hr rec 40' mud  
980#  
DST 4772-4810 open 1 hr. rec 1740' SW  
1550#  
DST 5213-40 open 1 hr rec 14' mud  
DST 5407-81 open 1 hr 1½ MCFG 405'  
GCM 1640#  
DST 5481-5505 open 1 hr rec 40'  
mud. 190# Miss 5525  
DST 5768-80 open 1 hr. rec 55' mud  
1210# Morrow 5410' Chester 5560  
St. Gen. 5664' TD 5780' 5" @ 5537  
CO to 5500 16/5416-20 24/5425-31  
7 GO 1 hr. 24/5440-44 48/5450-60  
sd-frac. 4 MCFG  
Comp. 5 MCFGPD

**COMPLETED**



SEP 25 1958

Scout Cards	DD
Land Small Map	
Land Wall Map	BJ
Tracings	
France Map	
Pierce Map	
Misc.	



Scout Cards

*2077*

Land Small Map

Land Wall Map

Tracing

France Map

*59*

Pledge Map

Map

NOV 24 1953

Comp. 5 m r p p d

48 / 5450-60 sd-trac 4 m r p p d

24 / 5425-31 7 sp-1 hr-24 / 5440-44

5" @ 5587 CO to 5500 16 / 5416-20

Chester 5560 St. Gen. 5664

5780

Prig. Data