

DX 78-1


Seward

KANSAS

Section 18 Township 31 Range 32 W

Well No. # 1 Lower Gas Unit

Company Stanolind

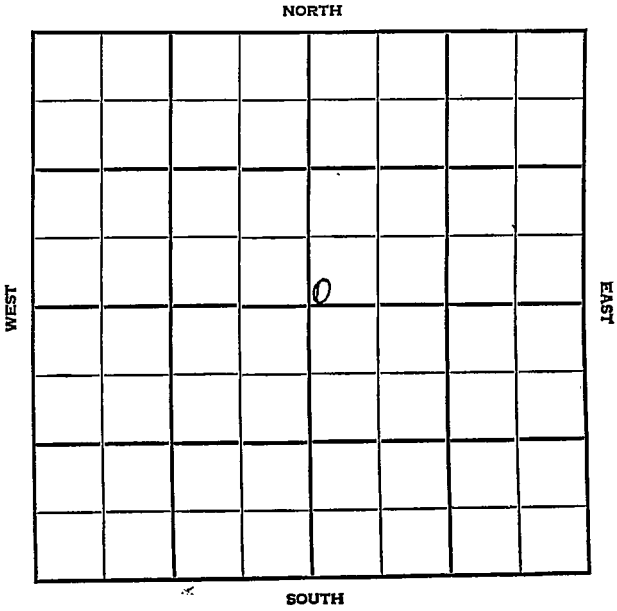

Seward KANSAS

SEC.	TWP.	R.
18	31	32W

WELL NO. 1 Lower Gas Unit FARM

COMPANY Stanolind

CONTRACTOR


Hugoton Pool

_____ Ft. from N. Line

150 _____ Ft. from S. Line

_____ Ft. from E. Line

150 _____ Ft. from W. Line

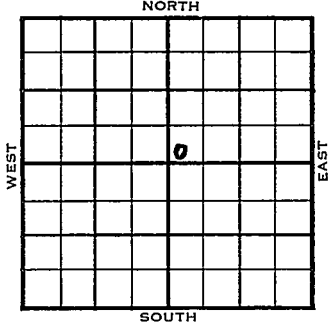

SW SW NE

	ELEVATION	REPORT
1954	2868'	

11/10
12/15

Location
 Spud 11-12-54 Gas well TD 2706
 8-5/8" @ 578 Her. 2603 Kri. 2644
 Win. 2685 TD 2706 5" @ 2681
 CO to 2706 5000 A 755,000 CFG
 30 GAWPH 8000 A 876,000 CFG
 PB 2674 108/2644-62 4750 A
 1,518,000 CFG 30 GAWPH PB 2636
 48/2606-14 24/2620-24 3500 A
 782,000 CFG 80 GAWPH CO to 2706
 Comp. 4,170,000 CFGPD 345#

COMPLETED

