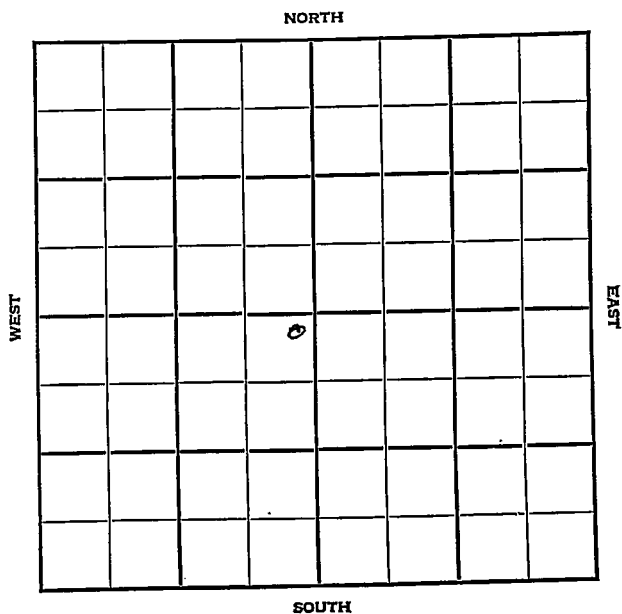


Section 18 Township 31 Range 33-WWell No. #1 Adams "E"Company Cities Service

KANSAS

Seward

Sec. 18 Twp. 31 R. 33W ✓

Well No. #1 Adams "E" Farm

Cities Service

Company

Hugoton Pool


100' Ft. from N. Line

Ft. from S. Line

100' Ft. from E. Line

Ft. from W. Line

NE SW

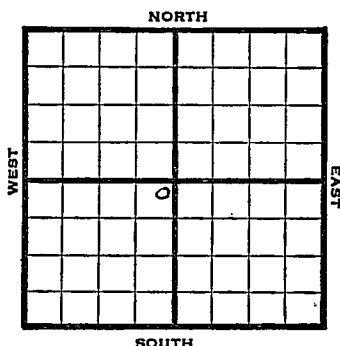

1948

Elev. 2872' REPORT

7/21 Location
7/28 RUR
8/4 8" @ 600'
Drlg. 2618'
8/11 TD 2724(
5" @ 2723'
8/18 "
8/25 "
9/1 150 shots 2668-98 - 8000 acid
9/8 130 shot 2610-36
160 " 2564-96
30 " 2540-46 - 3000 acid
9/14 "
9/22 5" @ 2723'
TD 2724'
Perf.
38,000 acid
Gas 28,500,000
R. Pr. 419#

COMPLETED

Map No. _____ Sec. 18 Twp. 31 R. 33W

Well No. 1 Adams "E"

_____ Cities Service _____ Company

FIRST REPORT

_____ Contractor

NE SW

SECTION PLAT

100 Ft. from N. Line

_____ Ft. from S. Line

100 Ft. from E. Line

_____ Ft. from W. Line

Seward County

Location X

Rig up _____

Drilling and Remarks: _____

RECORD

Cased _____ in., _____ ft.

Sand _____

Gas _____

Oil _____

Total Depth _____

PRODUCTION

1st 24 hrs. Nat. _____

1st 24 hrs. after shot _____

Gas _____ Cu. Ft.

Dry Hole _____

Abandoned _____

Date

JUL 21 1948 19 S. J. LEWIS Scout

Seward County Kansas State

Map No. _____ Sec. 18 Twp. 31 R. 33W

Well No. 1 Adams "E"

Cities Service Company

COMPLETE

Contractor

NE SW 515

E1.2872

SECTION PLAT

100 Ft. from N. Line

_____ Ft. from S. Line

100 Ft. from E. Line

_____ Ft. from W. Line

Hugoton Pool

Remarks:

5" @ 2723

YD 2724

Perf.

88000 acid

28,500,000 Gas

419 # R 1/2

Date

Scout

SEP 22 1948

S. J. LEWIS