

Sec. 18 Twp. 31 Range 35W

~~#~~ 1 Hinshaw Est.

Kansas Geological Society

Magnolia

Skelly Scout Tickets

Sec. 18 Twp. 31 R. 35W

Well No. #1 Hinshaw Est. Farm

Magnolia Company


Hugoton Pool

330' Ft. from N. Line

Ft. from S. Line

Ft. from E. Line

330' Ft. from W. Line

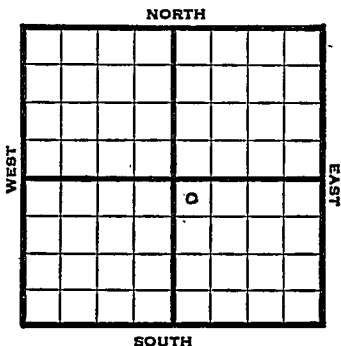

NW SE

1948

Eli 3011'

REPORT

7/8

10" @ 640'

7/14

WOC

TD 2788'

7" @ 2781'

7/21

168 shots 2700-36 7000 acid

96 shots 2650-70 7000 acid

144 shots 2596-2628 7000 acid

7/28

"

"

8/4

7" @ 2787'

TD 2788'

Perf 21000 acid

20,450,000 Gas

410 # R Pr.

Comp

COMPLETED