

Summer


KANSAS

SECTION 18 TOWNSHIP 31 RANGE 1 W

WELL NO. #1 - Zogleman

COMPANY Musgrove Pet.

NORTH

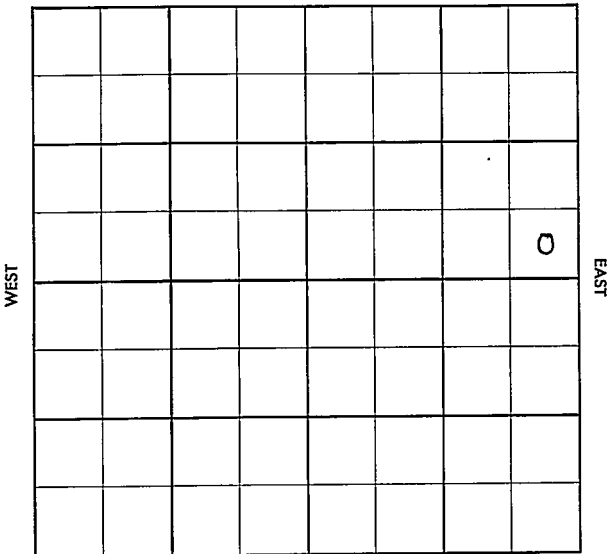

SOUTH

Sumner

KANSAS

SEC. 18	TWP. 31	R. 1W
------------	------------	----------

WELL NO. #1 Zogleman FARM

COMPANY Musgrove Pet.

CONTRACTOR Co. Tools

Wellington


Ft. from N. Line

Ft. from S. Line

Ft. from E. Line

Ft. from W. Line

SE SE NE

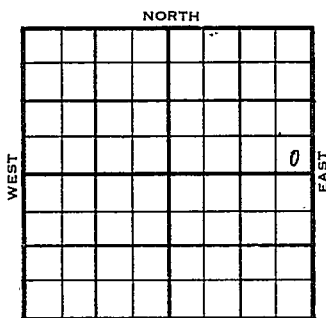

NCRA - DHM

1956	ELEVATION 1283	REPORT
------	-------------------	--------

1-25 Comm. 1-18-56
8" @ 300/100
Drlg. 2615

2-1 D & A
Stal 2782
KC 3085
M. 3692
TD 3783

ABANDONED

County Sumner

Elev. _____

Sec. 18Twp. 13NRge. 1W

Company _____

Musgrove Pet.

Farm Name _____

ZoglemanNo. 1

TOPS

DEPTH

LOG

DATUM

Loc. in Sec. _____

Anh. _____

Tp. _____

H. _____

Tr. _____

Dg. _____

Bl. _____

L. _____

K.C. _____

B.K.C. _____

Ce. _____

C. _____

M. _____

M. _____

K. _____

Mz. _____

Ma. _____

V. _____

S. _____

S. _____

A. _____

R. _____

Pe. _____

G. _____

T.D. _____

SE SE NE

Geol. _____

Contr. _____

Co. tools

Pool _____

Wellington

FIRST REPORT

JAN 25 1956

Date Comm. 1-18-56

NCRA - DHM

8" @ 300/100 drlg. 2615

County Sumner Elev. 1283
 Sec. 18 Twp. 31 Rge. 1W
 Company Musgrove Pet.
 Farm Name Zogleman No. 1

TOPS	DEPTH	LOG	DATUM	Loc. in Sec.
Anh.				SE SE NE
Tr.				
Dg.				
Bl.				
L.				
K.C.	3085		1802	Geol.
B.K.C.				Contr.
Ce.				Co. tools
C.				
M.	3692		2409	Pool
M.				Wellington
K.				
Mz.				
Mq.				
V.				
S.				
S.				
A.				
R.				
Pe.				
G.				
T.D.	3783			

Loc. in Sec.

SE SE NE

Geol.

Contr.

Co. tools

Pool

Wellington

ABANDONED

Date Comm. 1-18-56

FEB 1 1956

8" @ 300/100

D & A-