


Well No. 1 - Stanton Farm

Pinewood Oil Company

NORTH

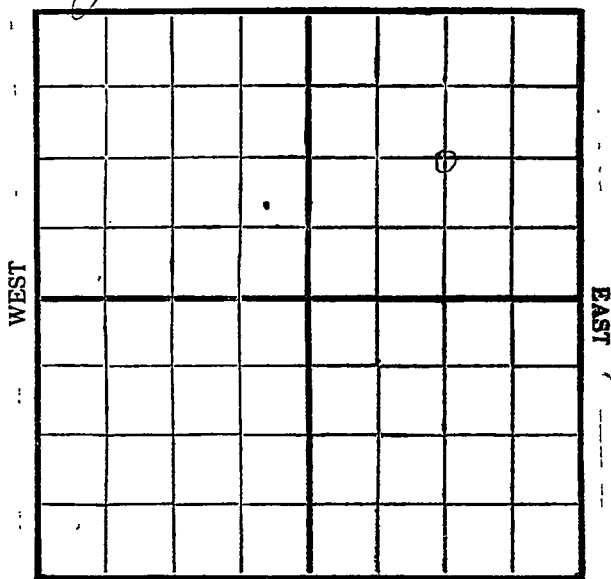

SOUTH

Location _____

Drilling Remarks

Rig Up _____

Drilling Remarks

RECORD

Cased _____ in. _____ ft.

Sand _____

Gas _____

Oil _____

Total Depth _____

PRODUCTION

1st 24 hrs. Nat. _____

1st 24 hrs. after shot_____

Gas_____cu. ft._____

Dry Hole_____

Abandoned _____


Map No. KANSAS Sec. 18 Twp. 31 R. 2^W
 Well No. 1 - Stayton Farm
Kingwood Oil Company

1320 Ft. from N. Line

_____ Ft. from S. Line

1320 Ft. from E. Line

_____ Ft. from W. Line

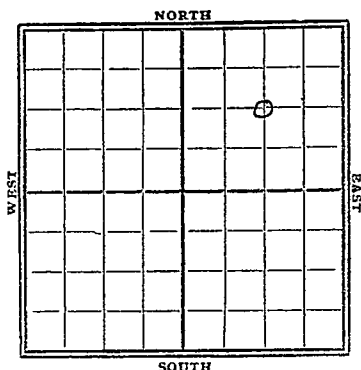

1929

Date

REPORT

9/11	Rig
9/18	Rig W up
9/25	S.D. 200'
10/2	15" - 590'
10/9	Drly 1150'
10/16	S.D. 1400'
10/23	Drly 1732'
10/30	U/R 10" - 2220'
11/6	S.D. 2612'
11/13	Set 8" - 2925'
11/20	U/R 8" - 3110'
11/27	Top T.C. line 3115'
	Drly 3225'
12/4	" 3412'
12/11	" 3540' 6" - 3530'
12/23	Top chat 3845'
	S.D. 3855' no show
12/30	—
1930	
1/8	Top chat 3852-58
	show oil
	3 bails water at 3874
	drly 3920'

1/15- 5D. 3920'

1/22 —

1/29 —

2/4 Dalg. 4005

2/11- Sdy. line 4147-4152

N. 7W- Dalg 4200

2/19- Base line 4205-

Top Wilcox 4290-4320

Water 4310 Dalg. 4325.

2/26- Top Wilcox 4290

Water at 4310'

T.D. 4361' (SLM)

Dry & Abandon

31 *Summer*
 Map No. **KANSAS** Sec. *18* Twp. *31* R. *2* *W*

Well No. *1 Stayton*
Kingwood Oil Co Company

J Contractor

FIRST REPORTS

1370 Ft. from N. Line

_____ Ft. from S. Line

1370 Ft. from E. Line

_____ Ft. from W. Line

SECTION PLAT

Location _____

Rig up *✓*

Drilling and Remarks:

RECORD

Cased _____ in., _____ ft.

Sand _____

Gas _____

Oil _____

Total Depth _____

PRODUCTION

1st 24 hrs. Nat. _____

1st 24 hrs. after shot _____

Gas _____ Cu. Ft.

Dry Hole _____

Abandoned _____

Date

SEP 1 1 1929

CHAS. L. SHERWOOD

19

Scout

[Handwritten signature]

Returned.....	<i>[Signature]</i>
Cards.....	<i>[Signature]</i>
Tracing.....	<i>EXX</i>
France Map.....	<i>[Signature]</i>
Scarborough Map.....	<i>[Signature]</i>
Moody Map.....	
Scarborough Flat Book.....	
Moody P' t Book.....	

Map No. **KANSAS** Sec. **18** Twp. **31** R. **2 W**

Well No. **1** **Stanton**

Bingwood Oil Co Company

Contractor

SECTION PLAT

COMPLETE


1320 Ft. from N. Line

..... Ft. from S. Line

1320 Ft. from E. Line

..... Ft. from W. Line

ABANDONED

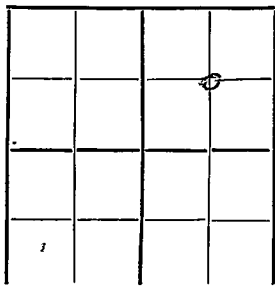

Location.....

Rig up.....

Drilling and Remarks:

top Wilcox 4290
water 4310

RECORD

Cased..... in., ft.

Sand.....

Gas.....

Oil.....

Total Depth **4361' SHM**

PRODUCTION

1st 24 hrs. Nat.....

1st 24 hrs. after shot.....

Gas..... Cu. Ft.

Dry Hole ☒

Abandoned ☒

Date

FEB 26 1930

192

CHAS. L. SHERWOOD

Scout

Returned

Cards

Tracing

France Map

Scarborough Map

Mealy Map

Scarborough Flat Book

Moody Flat Book