

KANSAS

Well No. #5 Kerschen

Company Consolidated Gas

WEST

EAST

SOUTH

Summer

KANSAS

SEC.	TWP.	R.
18	-- -- 31	3W

WELL NO. #5 Kerschen FARM

COMPANY Consolidated Gas

CONTRACTOR McKnab & Lindsay

Kerschen


_____ FT. FROM N. LINE

_____ FT. FROM S. LINE

_____ FT. FROM E. LINE

_____ FT. FROM W. LINE

SW NE NE

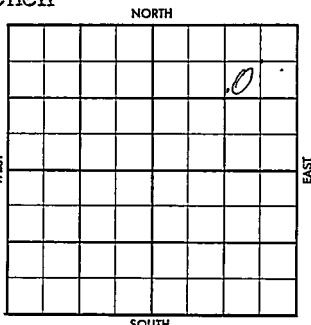

	ELEVATION	REPORT
1956		

8-1	Comm. 7-26-56 8" @ 375 w/300 Drlg. 1501
-----	---

County Sumner Elev. _____
Sec. 18 Twp. 31S Rge. 3W
Company Consolidated Gas
Farm Name Kerschen No. 5

TOPS	DEPTH	LOG	DATUM	Loc. in Sec.
Anb.				SW NE 1E
Sp.				
H.				
Tr.				
Dg.				
Bl.				
L.				Geol.
K.C.				Contr.
B.K.C.				Mcknab & Lind
Ce.				Say
C.				Pool
M.				Kerschen
K.				
Mz.				
Mo.				
V.				
S.				
S.				
A.				
R.				
Pe.				
G.				
T.D.				

Date Comm. 7-26-56 AUG 1 1956
8" 375 w/300; D 1501

[Handwritten signature]

[Handwritten initials]

[Handwritten initials]

Co.
No.
Sec.
T.
R.

County Sumner Elev. 1830 ft.
 Sec. 18 Twp. 31S Rge. 3W
 Company Consolidated Gas
 Farm Name Kerschen No. 5

TOPS	DEPTH	LOG	DATUM	Loc. in Sec.
Anh.				SW NE NE
TP.				
H.				
Tr.				
Dg.				
BL.				
L.				Geol.
K.C.	3299			Contr.
B.K.C.				Ticknab & Ling
Ce.				Say
C.				
M.				Pool
M.				Kerschen
K.				
Mz.				
Me.				
V.				
S.				
S.				
A.				
R.				
PE.				
G.				
T.D.	3530			

Date Comm. 7-26-56
8" 375 w/300; D 1501 AUG 3 '56 7" @ 3530
AUG 15 '56 48/3435-43 \$ 1 1/2 Boph
no/w in AUG 22 '56 \$ 14 Boph
no/w T&R POK AUG 29 '56 SEP 5 '56
SEP 12 '56 SEP 19 '56 SEP 26 '56 Ph P. 80
Bopd no/w to