
Harper KANSAS

SECTION 18 TOWNSHIP 31 S RANGE 6 W

WELL NO. # 2 M. H. King

COMPANY Skelly Oil Co.

~~SW~~ NE NE SE

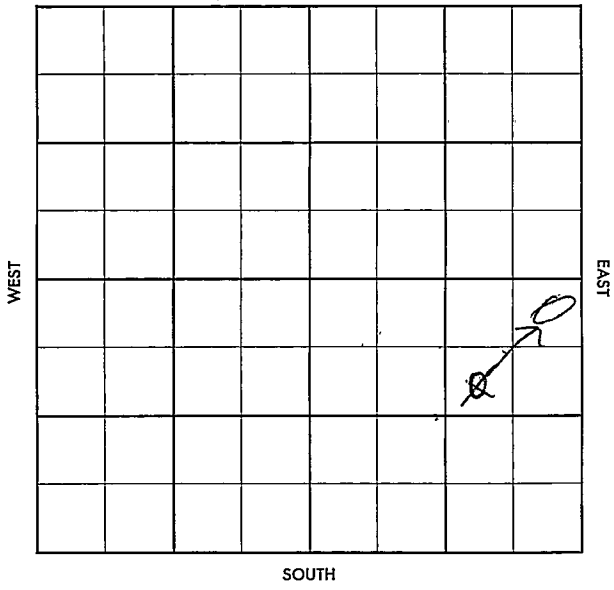

FORM 504-3 SUNRAY

FORM 513 SUNRAY

County Harper Elev.

Sec. 18 Twp. 31 Rge. 6W

Company Skelly Oil Co.

Farm Name M. H. King No. 2

TOPS	DEPTH	LOG	DATUM
Anh.			
T.P.			
H.			
Tr.			
Dg.			
Bl.			
L.			
K.C.			
B.K.C.			
Ce.			
C.			
M.			
M.			
K.			
Mz.			
Mq.			
V.			
S.			
S.			
A			
R.			
P€.			
G.			
T.D.			

Loc. in Sec. SW NE SE

Geol.

Contr. Wentworth Tool

Pool

FIRST REPORT

AUG 21 '57

Date Comm. 8-19-57

Drlg. 75

Co. Sec. T. R.

CORRECTION

FORM 513 SUNRAY

County Harper Elev. 1508

Sec. 18 Twp. 31 Rge. 6W

Company Skelly Oil Co.

Farm Name M. H. King No. 2

TOPS	DEPTH	LOG	DATUM
Anh.			
Tp.			
H.			
Tr.			
Dg.			
Bl.			
L.			
K.C.	3756		
B.K.C. Marm	4050		
Ce.			
C.			
M. Li	4340		
M.			
K.	4589		
Mz.			
Mo.			
V.			
S.			
S. Sd	4720		
A	4939		
R.			
P€.			
G.			
T.D.	4939		

Loc. in Sec. ~~SW~~ NE SE (NE-NE-SE NE)

Geol.

Contr. Wentworth Tool

Pool

COMPLETE

OCT 16 '57

Date Comm. 8-19-57

Drlg. 75 AUG 28 '57 8 5/8 629/350

IP 2425 SEP 4 '57 IP 3829 SEP 11 '57

DST 4342-59 1 hr 20 VSGCM

+90 Mdy SW FP 35-52

BH 465 cnd 4714-46 full

Rec IP 4802 5" 48 51/200

CO 4420 42/4722-29 SEP 25 '57

$ 7580 + 20 BW 24 hrs $ 1980

7 BW 6 hrs PB 4727 5/8

FORM 513-1 SUNRAY

25/4722-26 ϕ 12BO + 1½BW
12hrs 2" 4720 ϕ 4480
+ 5BW 11 hrs OCT 2 '57 OCT 9 '57
P 40 BO 4BW 24hrs
WO PDT OCT 16 '57
State 56 BO pd + 10%
37BO pd + wate

f8-31-6W