


Section 18 Township 31 Range 8WWell No. 1 Darnes "C"Company Republic Natural

NORTH

WEST

EAST

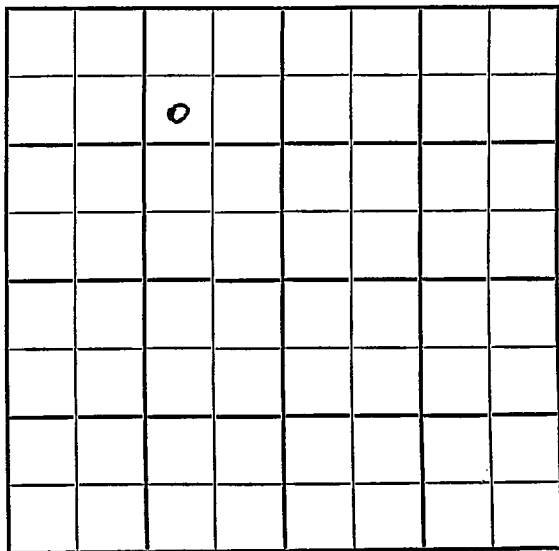

SOUTH

Harper KANSAS

SEC.	TWP.	R.
18	31	8W

WELL NO.

1 Darnes "C"

FARM

COMPANY

Rupublic Natural

CONTRACTOR

Anschutz

SE Grabs Pool


990 Ft. from N. Line

Ft. from S. Line

990 Ft. from E. Line

Ft. from W. Line

SW NE NW

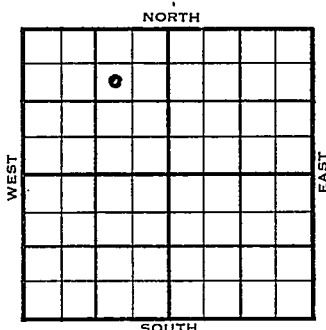

ELEVATION	REPORT
1954 1616'	

11/10
1955
2/2


MIR

Spud 11-10-54 Oil well TD 4481
8" @ 104 Miss 4388 TD 4481 5" @ 4481
CO to 4420 60/4395-4405 250 M-A
Sd-oil-frac S/147 BO 147 BW 20 hr.
Comp. 36 BOPD 38% wtr.

COMPLETED

FABEN GILSTRAP

County Harper State Kansas
 Sec. 18 (Blk.) 31 (Sur.) 8W Map No. _____
 Operator Republic Natural
 Well No. 1 Farm Darnes "C"
 Elev. 1616 Location SW NE NW

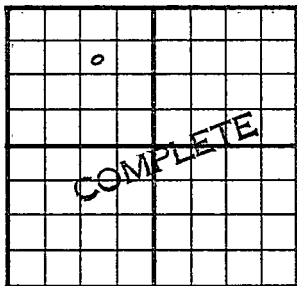

990 Ft. From N Line NW
990 Ft. From E Line Quarter
 1st. Report _____
 Completion FEB 2 1955
 Remarks SE Grabs Pool
Anschutz - Contr.
 Spudding Date 11-10-54

Drlg. Data Oil well TD 4481
8" @ 104 Miss. 4388 TD 4481 5" @ 4481
CO to 4420 60/ 4395-4405 250 M-A
sd-oil-frac S/ 147 bo 147 bw 20 hr.
Comp. 36 bopd 38% wtr.

FABEN GILSTRAP