


FORM 51 Harper

KANSAS

Section 18 Township 31 Range 8W

Well No. 1 Darnes

Company Beardmore Drlg.

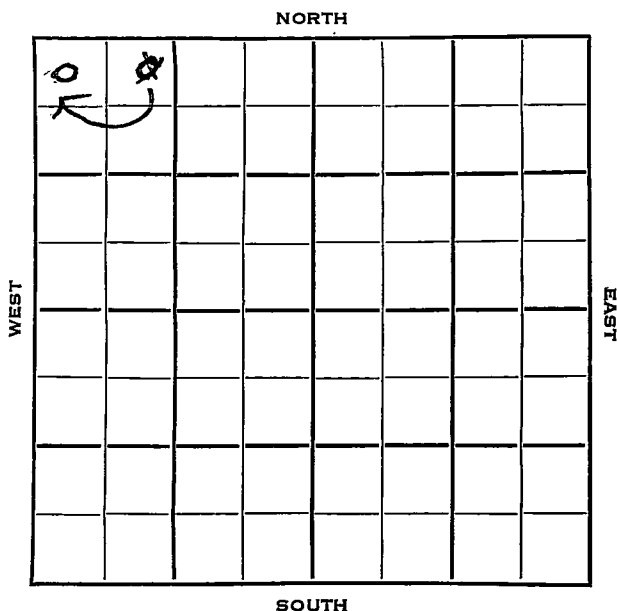

Sec. 18 Twp. 31 R. 8 W

Well No. # 1 Darnes Farm

Beardmore Drlg. Company

Contractor


330 Ft. from N. Line

Ft. from S. Line

Ft. from E. Line

330
990 Ft. from W. Line

NW
~~NE~~ NW NW

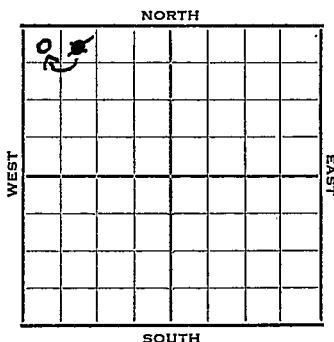

1952	Elev. 1614	REPORT
11/26	Location	
12/4	8" @ 195'	
12/11	Lans 3606 Ø3800	
12/18	Miss 4358 DST 4375-83 1½ Hr 85' SO&GCM 900# DST 4382-99 1 Hr. 121 O&GCM 645# RTD 4445 5" @ 4439	
12/25	" " " " "	
1/1	CO Testing	
1/8	Testing	
1/22	"	
1/29	"	
2/5	NR	
2/11	Spudding Date 2/11/30/52 Oil Well TD 4459 8" @ 195 Lans. 3606 Miss. 4358 DST 4375-83 open 1½ hr. Rec. 85' vso & gcm 900# DST 4382-99 open 1 hr. Rec. 120' o & gcm 645# TD 4445 5" @ 4439 DD 447 FU 1000' wtr. 12 hr. S/dry S/15 gwph ¼ goph shut in 10 hr. FU 210' wtr. 5' oil DD 4459 1½ bwph ¼ goph PB 4436 Perf/ 4410- 20 st-frac S/4 bfph 50% oil FU 1000' fluid 60% oil 12 hr. S/2½ boph	

OVER

1953

2/11 40% wtr. F/30 bo 35 bwpd 350,000 gas
Comp. 25 bopd 30 bw

COMPLETED

County Harper State KansasSec. 18 (Blk. 31) (Sur. SW) Map No. 31Operator Beardmore Drlg.Well No. 1 Farm DarnesElev. Location NE NW NW

0							

330 Ft. From N Line NW990 Ft. From W Line Quarter1st. Report NOV 26 1952Completion Remarks Spudding Date Drlg. Data Location

J. G. McGEHEE

NOV 28 1952

Scout Cards *mm*
Land Small Map *3*
Land Wall Map
Tracings
France Map
Pierce Map
Misc.

Orig. Data

Kansas

Map No. _____ Sec. 18 Twp. 31 R. 8WWell No. 1 Darnes

Beardmore Dr.l.g. _____ Company _____

Contractor _____

NW NW NW

CORRECTION

SECTION PLAT

330 Ft. from N. Line

_____ Ft. from S. Line

_____ Ft. from E. Line

330 Ft. from W. Line

o			

Harper County

Location _____

Rig up _____

Drilling and Remarks:

Reported
NE NW NW

RECORD

Cased _____ in., _____ ft.

Sand _____

Gas _____

Oil _____

Total Depth _____

PRODUCTION

1st 24 hrs. Nat. _____

1st 24 hrs. after shot _____

Gas _____ Cu. Ft.

Dry Hole _____

Abandoned _____

Date

DEC 3, 1952 19

J. G. McGEHEE Scout

Scout Cards

Land Small Map

Land Wall Map

Tracings

France Map

Pierce Map

Misc.

DEC 5 1952

County Harper State Kansas
 Sec. 18 (Blk. 31) (Sur. 8W) (Twp.) Map No.
 Operator Bearmore Drlg.
 Well No. 1 Farm Darnes
 Elev. 1614 Location NW NW NW

0					

330 Ft. From N Line NW

330 Ft. From W Line Quarter

1st. Report

Completion FEB 11 1953

Remarks

Spudding Date 11-30-52

Drlg. Data Oil well TD 4459

8" @ 195 Lans. 3606 Miss. 4358

DST 4375-83 open $1\frac{1}{4}$ hr. Rec. 85' vso &

gcm 900# DST 4382-99 open 1 hr.

Rec. 120' o & gcm 645# TD 4445 5" @

4439 DD 4447 FU 1000' wtr. 12 hr.

S/ dry S/ 15 gwph $\frac{1}{4}$ goph shut in 10 hr.FU 210' wtr. 5' oil DD 4459 $1\frac{1}{2}$ bwph $\frac{1}{4}$ goph PB 4436 Perf/ 4410-20 st-frac

S/ 4 bfph 50% oil FU 1000' fluid 60% oil

12 hr. S/ $2\frac{1}{2}$ boph 48/ 4391-97 S/ $2\frac{1}{4}$ bfph 50% wtr. Hydro. F/ $2\frac{1}{2}$ bfph

40% wtr. F/ 30 bo 35 bwph 350,000 gas

Comp. 25 bopd 30 bw

J. G. McGEHEE

Scout Cards *SS.*

Land Small Map

Land Wall Map *3*

racings

Land Map

Water Map

File

FEB 18 1953

Drig. Data