
DX 78-1

Harper KANSAS

Section 18 Township 31 Range 8 W

Well No. # 1 Darnes "B"

Company Republic Natural Gas

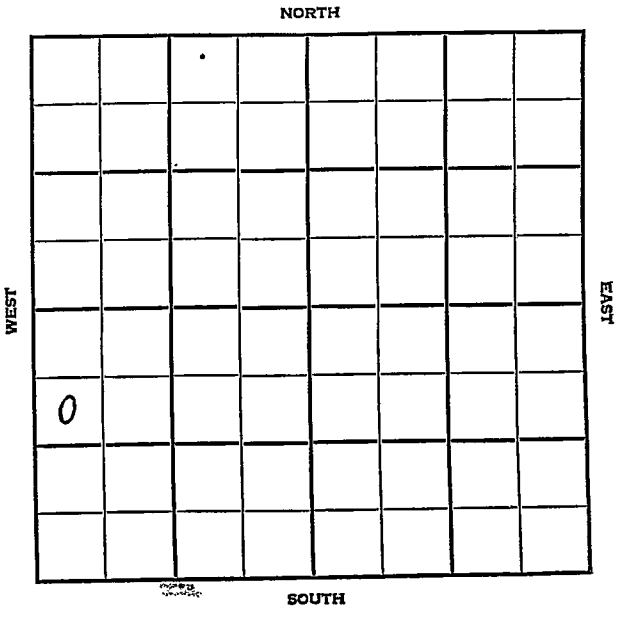

Harper KANSAS

SEC.	TWP.	R.
18	31	8 W

WELL NO. #1 Darnes "B" FARM

COMPANY Republic Natural Gas

CONTRACTOR Anschutz

Grabs Pool


990 Ft. from N. Line

Ft. from S. Line

Ft. from E. Line

330 Ft. from W. Line

SW NW SW

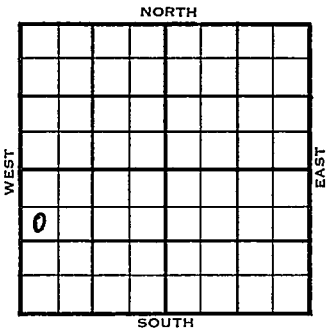

1955	ELEVATION ± 1608'	REPORT
1/12	Spud 1-7-55 8" @ 171 Drlg. 1874'	
6/22	Comm - 1-7-55 8" @ 171/150 5" @ 4472 CO 32/4390-98 frac F/47 bfpd 90% wtr F/25 bf 90% wtr 24 hr. F/25 bf 24 hr 75% wtr 480 mcfg F/28 bf 24 hr 90% wtr 480 mcfg Comp shut in gas well 500 mcfgpd	

COMPLETED

DX-78

FORM 275 FOR SALE BY KANSAS BLUE PRINT CO.

County Harper State Kansas

Sec. 18 (Blk. Twp.) 31 (Sur. Rge.) 8W Map No.

Operator Republic Natural Gas

Well No. 1 Farm Darnes "B"

Elev. Location SW NW SW



990 Ft. From N Line SW

330 Ft. From W Line Quarter

1st. Report JAN 1 2 1955

Completion

Remarks

Anschutz - Contr.

Spudding Date 1-7-55

Drlg. Data Grabs Pool

8" @ 171 drlg. 1874

FABEN GILSTRAP

FORM 513 REV. SUNRAY

County Harper Elev. 1608

Sec. 18 Twp. 31 Rge. 8W

Company Republic Natural Gas

Farm Name Darnes "B" No. 1

TOPS	DEPTH	LOG	DATUM
Anh.			
Tp.			
H.			
Tr.			
Dg.			
Bl.			
L.			
K.C.			
B.K.C.			
Ce.			
C.			
M.	4358		2750
M.			
K.			
Mz.			
Mo.			
V.			
S.			
S.			
A			
R.			
P€.			
G.			
T.D.	4373		

Loc. in Sec. SW NW SW

Geol.

Contr. Anschutz

Pool Grabs

COMPLETE

o

Date Comm. 1-7-55

JUN 2 2 1955

8" @ 171/150 5" @ 4472 CO

32/ 4390-98 frac F/ 47 bfpd 90% wtr

F/ 25 bf 90% wtr. 24 hr. F/ 25 bf

24 hr. 75% wtr. 480 mcfg F/ 28 bf

24 hr. 90% wtr. 480 mcfg

Comp. shut in gas well 500 mcfgpd

Co. Lse. No. Sec. T. R.