

DX 78-1

Barber


KANSAS

Section 19 Township 31 Range 11 W

Well No. # 1 Catlin

Company Rupp-Ferguson

NORTH

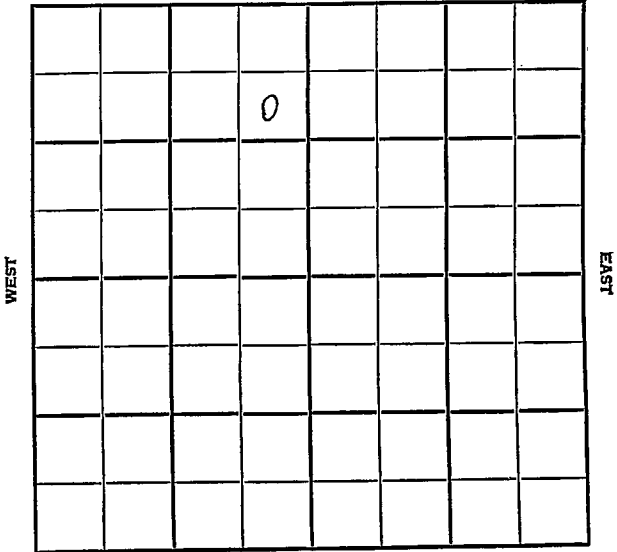

SOUTH

Barber KANSAS

SEC.	TWP.	R.
19	31	11W

WELL NO.

1 Catlin

FARM

COMPANY

Rupp-Ferguson

CONTRACTOR

Co. Tools


Wildcat

990 Ft. from N. Line

Ft. from S. Line

330 Ft. from E. Line

Ft. from W. Line

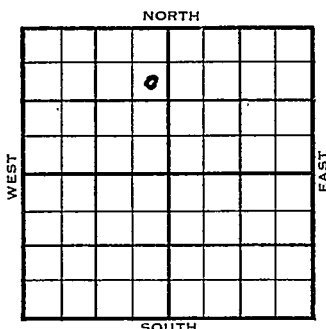

SE NE NW

Hannum FO

	ELEVATION	REPORT
1954	1585'	


9/29 MIRT

10/20 Spud 9-28-54 D & A TD 4730
 8-5/8" @ 227 Elgin sd 3452
 DST 3447-80 open 1 hr rec 35' muddy
 wtr. 1220# Doug. 3680
 DST 3670-95 open 1 hr rec 475' muddy
 SW 1540# Br. lime 3746 Lans 3756
 Cong. 4320
 DST 4320-45 open 25 min, rec 18' mud
 Off Miss. chert 4400 Kh. 4429
 Viola 4583 Simp. sh. 4670'
 Simp. sd. 4698' TD 4730'
 D & A

ABANDONED

FABEN GILSTRAP

County Barber State Kansas
 Sec. 19 (Blk.) 31 (Sur.) 11W Map No.
 Operator Rupp-Ferguson
 Well No. 1 Farm Catlin
 Elev. 1585 Location SE NE NW

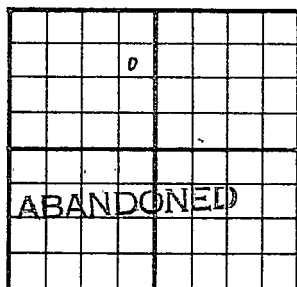

990 Ft. From N Line NW
330 Ft. From E Line Quarter
 Ist. Report
 Completion OCT 20 1954
 Remarks Wildcat
Co. tools
 Spudding Date 9-28-54

Drlg. Data D & A TD 4730
8 5/8" @ 227 Elgin sd. 3452 DST 3447-80
open 1 hr. Rec. 35' muddy wtr. 1220#
Doug. 3680 DST 3670-95 open 1 hr.
Rec. 475' muddy sw 1540# Br. lime 3746
Lans. 3756 Cong. 4320 DST 4320-45
open 25 min. Rec. 18' mud 0#
Miss. chert 4400 Kh. 4429 Viola 4583
Simp. sh. 4670 Simp. sd. 4698
TD 4730

D & A

FABEN GILSTRAP