

KANSAS


Barber

Form 51-5M-7-40-Palace

Section 19 Township 31 Range 11-W

Well No. #1 Nuckols "B" (*Nuckolls*)

Company Larioj

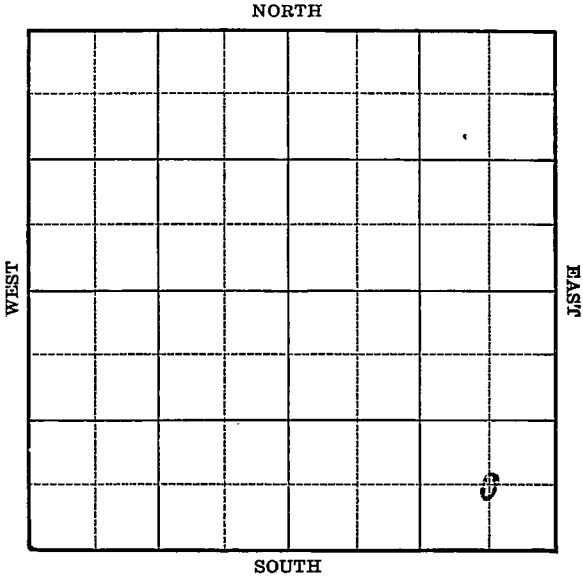

Map No. 61 Sec. 19 Twp. 31 R. 11W

Well No. 1 Nuckols "B"

Lario Company

Contractor

FIRST REPORT

SECTION PLAT


C SE SE

 Ft. from N. Line

622 Ft. from S. Line

660 Ft. from E. Line

 Ft. from W. Line

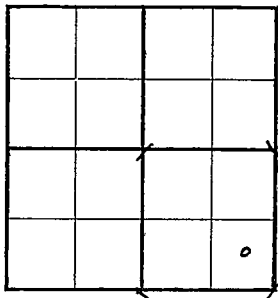

WHELAN POOL

Location

Rig up

Drilling and Remarks:
Oellar

RECORD

Cased in., ft.

Sand

Gas

Oil

Total Depth

PRODUCTION

1st 24 hrs. Nat.

1st 24 hrs. after shot

Gas Cu. Ft.

Dry Hole

Abandoned

Date

DEC 30 1940 19

S. J. LEWIS Scout

Map No. 61 Sec. 19 Twp. 31 R. 11WWell No. 1 Nuckols "B"Lario Oil & Gas Company

Contractor

~~ABANDONED~~

SECTION PLAT

C SE SE

 Ft. from N. Line622 Ft. from S. Line660 Ft. from E. Line Ft. from W. Line

			o

WHELAN POOL

Location Rig up

Drilling and Remarks:

*Miss 4337 1/2**5" @ 4339**Noshow*

RECORD

Cased in., ft.Sand Gas Oil Total Depth 4436

PRODUCTION

1st 24 hrs. Nat. 1st 24 hrs. after shot Gas Cu. Ft.Dry Hole Abandoned

Date

FEB 5 1941 19S. J. LEWIS Scout