

# KANSAS


FORM 51 5M 4-41 PETROL

Barber

Section 19 Township 31 Range 11-W

Well No. #1 Williams

Company Olson Oil

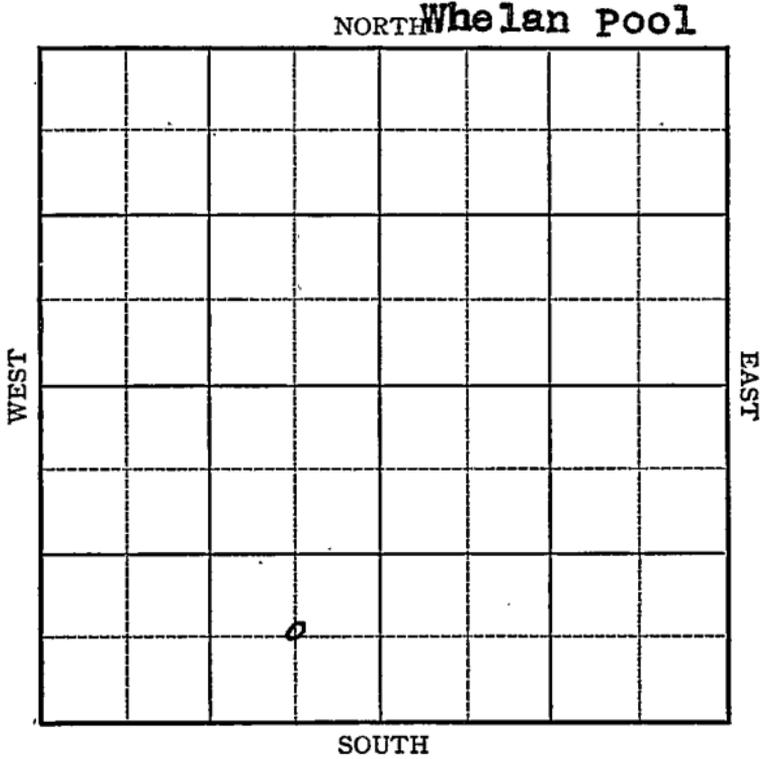

Sec. 19 Twp. 31 R. 11-W

Well No. #1 Williams Farm

Olson Oil Company

(Wheeler)


\_\_\_\_\_ Ft. from N. Line

660 Ft. from S. Line

660 Ft. from E. Line

\_\_\_\_\_ Ft. from W. Line

Elev. 1558

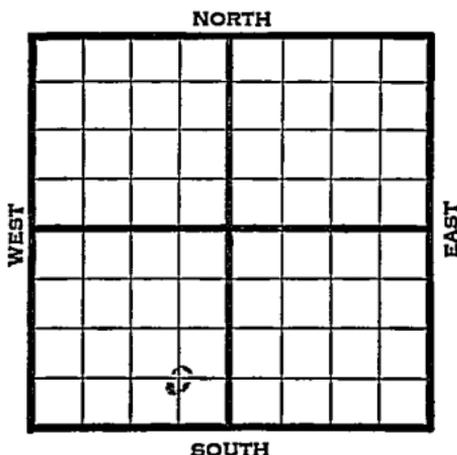

1941	REPORT
4/30	8" - 108'
	Drlg. 225'
5/8	Drlg. 2980'
5/15	Lans. 3720' Drlg. 4190'
5/22	Miss. 4318' 5" - 4317'
	T.D. 4363' 10 gals. oil per hr.
5/27	Miss. 4318'
	5" - 4317'
	T.D. 4363'
	Shot 40 qts. on bottom.
	No shows.
	<b>COMPLETED</b>

Map No. 61 Sec. 19 Twp. 31 R. 11WWell No. 1 WilliamsOlson Oil

Company

Contractor

**FIRST REPORT**

C SE SW

\_\_\_\_\_ Ft. from N. Line

660 Ft. from S. Line660 Ft. from E. Line

\_\_\_\_\_ Ft. from W. Line

WHELAN POOL

**SECTION PLAT**


Location \_\_\_\_\_

Rig up \_\_\_\_\_

Drilling and Remarks:

8" - 108

Drlg. 225

**RECORD**

Cased \_\_\_\_\_ in., \_\_\_\_\_ ft.

Sand \_\_\_\_\_

Gas \_\_\_\_\_

Oil \_\_\_\_\_

Total Depth \_\_\_\_\_

**PRODUCTION**

1st 24 hrs. Nat. \_\_\_\_\_

1st 24 hrs. after shot \_\_\_\_\_

Gas \_\_\_\_\_ Cu. Ft.

Dry Hole \_\_\_\_\_

Abandoned \_\_\_\_\_

Date

APR 30 1941

19

S. J. LEWIS

Scout

Map No. 61 Sec. 19 Twp. 31 R. 11W

Well No. 1 Williams

Olson Oil Company

ABANDONED Contractor

**SECTION PLAT**


C SE SW

\_\_\_\_\_ Ft. from N. Line

660 Ft. from S. Line

660 Ft. from E. Line

\_\_\_\_\_ Ft. from W. Line

**WHELAN POOL**

Location \_\_\_\_\_

Rig up \_\_\_\_\_

Drilling and Remarks:

*Miss 4318*  
*5" @ 4317*  
*40 ft. to 4317*  
*No shows*

**RECORD**

Cased \_\_\_\_\_ in., \_\_\_\_\_ ft.

Sand \_\_\_\_\_

Gas \_\_\_\_\_

Oil \_\_\_\_\_

Total Depth 4363

**PRODUCTION**

1st 24 hrs. Nat. \_\_\_\_\_

1st 24 hrs. after shot \_\_\_\_\_

Gas \_\_\_\_\_ Cu. Ft.

Dry Hole \_\_\_\_\_

Abandoned \_\_\_\_\_

Date

MAY 27 1941 19

S. J. LEWIS Scout