
FORM 51 25M 8-50 WESTERN Stevens KANSAS

Section 19 Township 31 Range 38W

Well No. #1 Reynolds

Company Hugoton Prod.

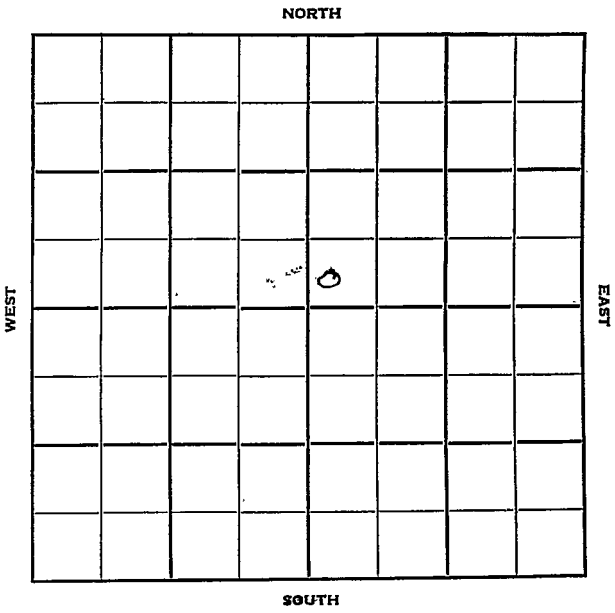

FORM 252-B
10M 8-51 TPCO.

Stevens

Sec. 19 Twp. 31 R KANSAS 38W

Well No. #1 Reynolds Farm

Hugoton Prod. Company

Contractor


Ft. from N. Line

200' Ft. from S. Line

Ft. from E. Line

200' Ft. from W. Line

SW SW NE

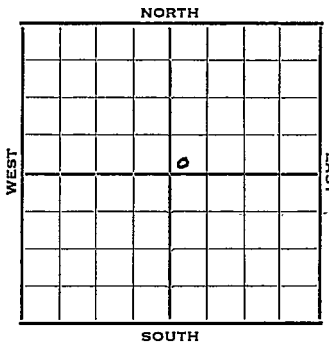

1952	Elev. 3171 REPORT
4/30	Location
5/7	"
5/14	"
5/21	"
5/28	10" @ 520 Drlg. 1640'
6/11	RTD 2395 7" @ 2383' DD 2628'
6/18	NR
6/25	Hol 2338 Her 2382 Up Krider 2401 Win 2475 Up Ft 2536
7/2	NR
7/9	NR
7/17	NR
7/23	"
7/30	"
8/6	"
8/13	"
8/20	"
8/27	"
9/3	"
9/10	16,000 A
9/17	NR

OVER

1952

9/24 Spud 5-22-52
Gas Well TD 2628
10" @ 520 7"@ 2383
TD 2628
Hol. 2338 Her. 2382 Kri 2401
Win. 2475 Ft. Riley 2536
16,000 A
Comp. 24,403,000 gas 375#
COMPLETED

FORM 275 FOR SALE BY KANSAS BLUE PRINT CO.


County Stevens State Kansas

Sec. 19 (Blk. Twp.) 31 (Sur. Rge.) 38W Map No.

Operator Hugoton Prod.

Well No. 1 Farm Reynolds

Elev. Location SW SW NE

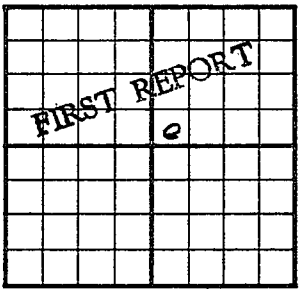

200 Ft. From S Line NE

200 Ft. From W Line Quarter

1st. Report APR 30 1952

Completion

Remarks

Spudding Date

Drlg. Data

Location

J. G. McGEHEE

MAY 2

Scout Cards
Land Small Map
Land Wall Map
Tracings
France Map
Pierce Map
Misc.

Drlg. Data

FORM 275 FOR SALE BY KANSAS BLUE PRINT CO.


County Stevens State Kansas

Sec. 19 (Blk. Twp.) 31 (Sur. Rge.) 38W Map No.

Operator Hugoton Prod.

Well No. 1 Farm Reynolds

Elev. 3171 Location SW SW NE

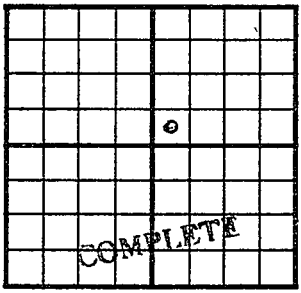

200 Ft. From S Line NE

200 Ft. From W Line Quarter

1st. Report

Completion SEP 2 4 1952

Remarks

Spudding Date 5-22-52

Drlg. Data Gas well TD 2628

10" @ 520 7" @ 2383 TD 2628

Hol. 2338 Her. 2382 Kri. 2401

Win. 2475 Ft. Riley 2536 16000 A

Comp. 24,403,000 gas 375#

J. G. McGEHEE

SEP 29 1952

Scout Cards	
Land Small Map	
Land Wall Map	
Tracings	
France Map	
Pierce Map	
Misc.	

Drlg. Data