

Section 19 Township 31 Range 37-WWell No. #1-19 FulkCompany Hugoton Prod.

NORTH

			0				

WEST

EAST

SOUTH

KANSAS
31

Stevens
37-W ✓

Sec. 19 Twp. R.

Well, No. #1-19 Faulk Farm

Hugoton Prod

Company

Contractor

2347'

Ft. from N. Line


Ft. from S. Line

Ft. from E. Line

2350'

Ft. from W. Line

SE NW

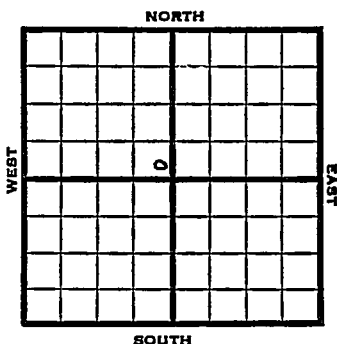

1951

Elev. 3133

REPORT

1/3

Spud 12-21-50

10" @ 538

7" @ 2443'

1/31

Spud 12/21/50

Gas well TD 2691

10" @ 538

7" @ 2443 TD 2691

Hol. 2402 Her. 2447 Krider 2466-2.2


2525 Win. 2541-81 Ft. Riley 2598

16000 A

Comp. 37, 940,000 gas

COMPLETED

County Stevens State Kansas
 Sec. 19 (Blk. 31 (Sur. 37W Map No. 37W)
 Operator Hugoton Prod.
 Well No. 1-19 Farm Fulk
 Elev. _____ Location SE NW

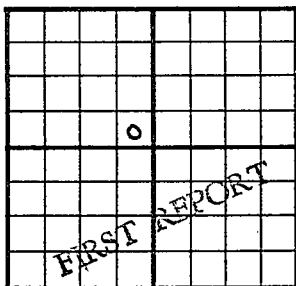

2347 Ft. From N Line NW
2350 Ft. From W Line Quarter
 1st. Report JAN 3 1951
 Completion _____
 Remarks _____
 Spudding Date 12-21-50

Drlg. Data

10" @ 538 7" @ 2443

J. E. TYRA

J. E. TYRA