
DX 78-1

Seward KANSAS

Section 19 Township 31 Range 32 W

Well No. # 1 Eubank Gas Unit

Company Stanolind

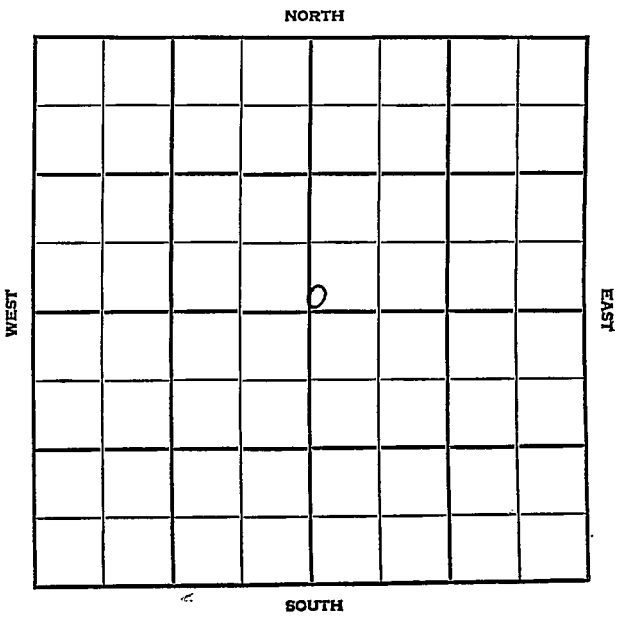

Seward KANSAS

| SEC. | TWP. | R. |
|---|---|---|
| 19 | 31 | 32W |

WELL NO.

#1 Eubank Gas Unit FARM

COMPANY

Stanolind

CONTRACTOR

Hugoton Pool


_____ Ft. from N. Line

150 Ft. from S. Line

_____ Ft. from E. Line

150 Ft. from W. Line

SW SW NE

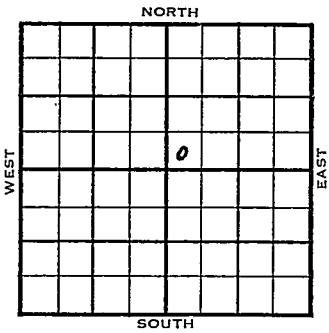


| 1954 | ELEVATION 2870' | REPORT |
|---|---|---|
| 11/3 | Spud 10-27-54<br>8" @ 598'<br>Her. 2632', Kri. 2674',<br>5" @ 2675'<br>TD 2712' | |
| 11/23 | Spud 10-27-54 - Gas Well<br>TD 2712'<br>8" @ 598'<br>Her. 2632', Kri 2674'<br>5" @ 2675'<br>TD 2712'<br>CO to 2712', 3750A<br>251,000 cfg, 150 gwph<br>PB 2668'<br>36/2634-40, 60/2650-60, 465,000 cfg<br>2500A 1250A<br>CO to 2712 104 mcfg 36 gwph<br>10000A<br>2,630,000 cfg<br>Comp. 8,669,000 cfgpd | |

COMPLETED

DX-78

FORM 275 FOR SALE BY KANSAS BLUE PRINT CO.


County Seward State Kansas

Sec. 19 (Blk. Twp.) 31 (Sur. Rge.) 32W Map No.

Operator Stanolind

Well No. 1 Farm Eubank Gas Unit

Elev. Location SW SW NE

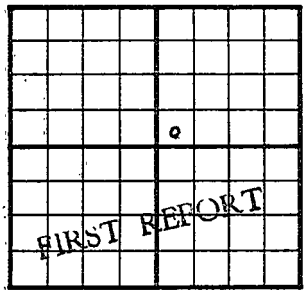


150 Ft. From S Line NE

150 Ft. From W Line Quarter

Ist. Report NOV 3 1954

Completion

Remarks

Spudding Date 10-27-54

Drlg. Data Hugoton Pool

8" @ 598 Her. 2632 Kri. 2674

5" @ 2675 TD 2712

FABEN GILSTRAP

FORM 275 FOR SALE BY KANSAS BLUE PRINT CO.


County Seward State Kansas

Sec. 19 (Blk. Twp.) 31 (Sur. Rge.) 32W Map No.

Operator Stanolind

Well No. 1 Farm Eubank Gas Unit

Elev. 2870 Location SW SWNE

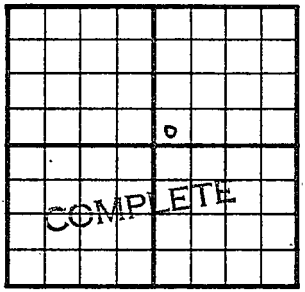


150 Ft. From S Line NE

150 Ft. From W Line Quarter

1st. Report

Completion NOV 23 1954

Remarks Hugoton Pool

Spudding Date 10-27-54

Drlg. Data Gas well TD 2712

8" @ 598 Her. 2632 Kri. 2674

5" @ 2675 TD 2712 CO to 2712 3750A

251,000 cfg 150 gwph PB 2668

36/ 2634-40 60/ 2650-60 465,000 cfg

2500 A 1250 A CO to 2712 104 mcfg

36 gwph 10000 A 2,630,000 cfg

Comp. 8,669,000 cfgpd

FABEN GILSTRAP