


KANSAS

Section 19 Township 31 Range 33WWell No. 1 RhinellCompany Terminal Cities Service

Hugoton

NORTH

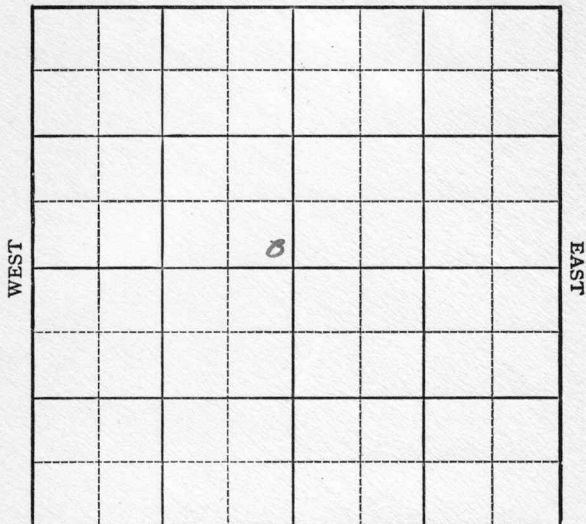

SOUTH


Seward KANSAS ✓

Sec. 19 Twp. 31 R. 33W

Well No. #1 Rhinell Farm
Germinal Service
Cities Service Company

Hugoton Pool (Lohman & Johnson, Cont.)

NORTH

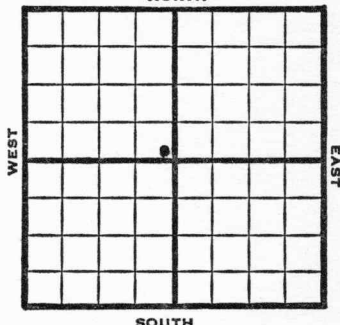

Ft. from N. Line

100'

Ft. from S. Line

100'

Ft. from E. Line

Ft. from W. Line

SE NW

1949

Elev. 2863' REPORT

8/10

Location

8/17

RUR

8/24

8" @ 560'
Drlg. 2310'

8/31

TD 2711
5" @ 2710'

9/7

140shots 2656-84
Acid 6500

9/14

250 shots 2560-2630
2500 acid

9/21

"

10/5

5" @ 2710'
Perf.
30000 acid
18,600,000 gas
410# R Pr.
TD 2711'
Comp.

COMPLETED

Map No. _____ Sec. 19 Twp. 31 R. 33W

Well No. 1 Rhinell

Cities Service Company

Lonman & Johnson Contractor

SE NW

FIRST REPORT
SECTION FLAT


_____ Ft. from N. Line

100 Ft. from S. Line

100 Ft. from E. Line

_____ Ft. from W. Line

Seward County

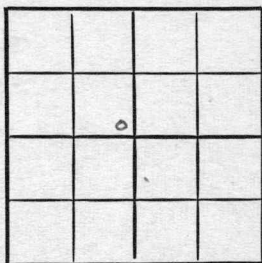

RECORD

Location X

Cased _____ in., _____ ft.

Rig up _____

Sand _____

Drilling and Remarks:

Gas _____

Oil _____

Total Depth _____

PRODUCTION

1st 24 hrs. Nat. _____

1st 24 hrs. after shot _____

Gas _____ Cu. Ft.

Dry Hole _____

Abandoned _____

Date

AUG 10 1949 19

S. J. LEWIS Scout

110

Scout Cards

Land Small Map

Land Wall Man

Tracings 798

France Map

Pierce Map 

Misc.

100

1

1

17

1

Kansas

Hugoton Pool

Map No. _____ Sec. 19 Twp. 31 R. 33WWell No. 1 Rhinell


Terminal Service

Company

COMPLETE

Contractor

SE NW

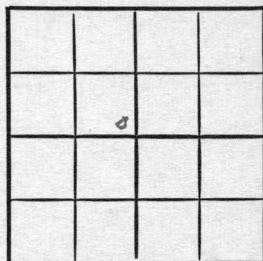E 12863
SECTION PLAT

_____ Ft. from N. Line

100 Ft. from S. Line100 Ft. from E. Line

_____ Ft. from W. Line

Seward County

Location _____

Rig up _____

Drilling and Remarks:

5" C2710Perf.30000 acid15,600,000 Gas410 * R 1/2

RECORD

Cased _____ in., _____ ft.

Sand _____

Gas _____

Oil _____

Total Depth 2711

PRODUCTION

1st 24 hrs. Nat. _____

1st 24 hrs. after shot _____

Gas _____ Cu. Ft.

Dry Hole _____

Abandoned _____

Date

OCT 5 1949

19

S. J. LEWIS

Scout

Name

Map No.

Sec

Twp

R


Well No.

Company

Contractor

COMPLETE

SECTION PLAN

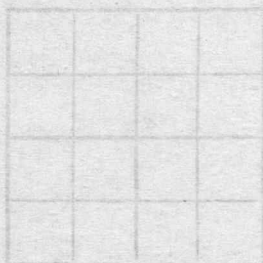

Ft. from N. line

Ft. from E. line

Ft. from S. line

Ft. from W. line

RECORD

Location

Dig up

Drilling and Remarks

Scout Cards

Land Small Map

Land Wall Map

Tracings

France Map

Pierce Map

Misc.

Date

Scout

LEWIS

10

Map No. _____ Sec. 19 Twp. 31 R. 33WWell No. 1 Rhinell

Terminal Service


Company

CORRECTION

Contractor

SE NW

SECTION PLAT

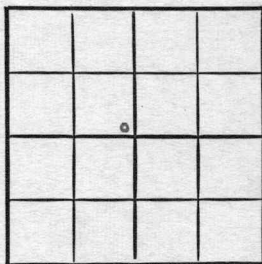

_____ Ft. from N. Line

100 Ft. from S. Line100 Ft. from E. Line

_____ Ft. from W. Line

Seward County

Location _____

Rig up _____

Drilling and Remarks:

Was Cities Service

RECORD

Cased _____ in., _____ ft.

Sand _____

Gas _____

Oil _____

Total Depth _____

PRODUCTION

1st 24 hrs. Nat. _____

1st 24 hrs. after shot _____

Gas _____ Cu. Ft.

Dry Hole _____

Abandoned _____

Date

SEP 28 1949

19

S. J. LEWIS

Scout

Sandy -

Is this Stevens
Co.? Is this
First Report & Corr.

Eddie

Scout Cards	<i>E. Smith</i>
Land Small Map	<i>LD</i>
Land Wall Map	
Tracings	
France Map	
Pierce Map	
Misc.	