


KANSAS

Stevens

Section 19 Township 31 Range 35W

Well No. 1 Moorhead

Company Magnolia

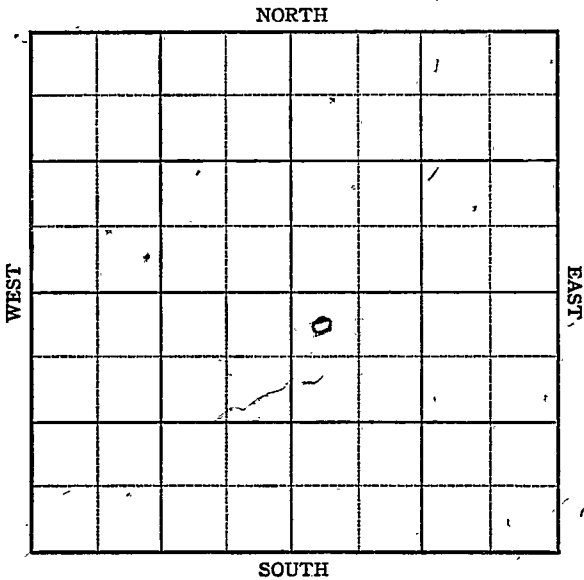

Sec. 19 Twp. 31 R. 35W

Well No. 1 Moorhead Farm  
Magnolia Company


Hugoton Pool

330 Ft. from N. Line

\_\_\_\_\_ Ft. from S. Line

\_\_\_\_\_ Ft. from E. Line

330 Ft. from W. Line

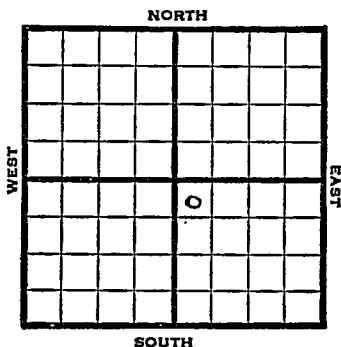

NW SE

1947 Elev. 3028' REPORT

5/28	Location
6/3	"
6/10	"
6/17	10" @ 752' Drlg. 1550'
6/24	Drlg. 2675'
7/1	TD 2822' 7" @ 2821' WOC
7/8	120 shots 2720-56' - 6000 acid. 120 shots 2660-87' - 7000 acid.
7/16	Acid 6000
7/22	"
7/30	7" @ 2821' Perf. 18000 Acid 11,150,000 Gas 420# R. Pr. TD 2822'

**COMPLETED**

Map No. \_\_\_\_\_ Sec. 19 Twp. 31 R. 35W

Well No. 1 Moorhead

Magnolia Company

**FIRST REPORT**

Contractor \_\_\_\_\_

NW SE

**SECTION PLAT**

330 Ft. from N. Line

\_\_\_\_\_ Ft. from S. Line

\_\_\_\_\_ Ft. from E. Line

330 Ft. from W. Line

		o	

Stevens County

Location X

Rig up \_\_\_\_\_

Drilling and Remarks:

**RECORD**

Cased \_\_\_\_\_ in., \_\_\_\_\_ ft.

Sand \_\_\_\_\_

Gas \_\_\_\_\_

Oil \_\_\_\_\_

Total Depth \_\_\_\_\_

**PRODUCTION**

1st 24 hrs. Nat. \_\_\_\_\_

1st 24 hrs. after shot \_\_\_\_\_

Gas \_\_\_\_\_ Cu. Ft.

Dry Hole \_\_\_\_\_

Abandoned \_\_\_\_\_

Date

MAY 28 1947 19

S. J. LEWIS Scout

Map No. 0 Sec. 19 Twp. 31 R. 35W

Well No. 1 Moorehead

Magnolia Company

COMPLETE Contractor

NW SE

*E 13028*  
SECTION PLAT

330 Ft. from N. Line

\_\_\_\_\_ Ft. from S. Line

\_\_\_\_\_ Ft. from E. Line

330 Ft. from W. Line

		o	

Stevens County

Location \_\_\_\_\_

Rig up \_\_\_\_\_

Drilling and Remarks:

*7" C2821*

*Perf.*

*18000 acid*

*11,150,000 Gas*

*420 # R P*

RECORD

Cased \_\_\_\_\_ in., \_\_\_\_\_ ft.

Sand \_\_\_\_\_

Gas \_\_\_\_\_

Oil \_\_\_\_\_

Total Depth 2822

PRODUCTION

1st 24 hrs. Nat. \_\_\_\_\_

1st 24 hrs. after shot \_\_\_\_\_

Gas \_\_\_\_\_ Cu. Ft.

Dry Hole \_\_\_\_\_

Abandoned \_\_\_\_\_

Date

JUL 30 1947 19

S. J. LEWIS Scout