

Harper

KANSAS

6W

SECTION 19 TOWNSHIP 31S RANGE

WELL NO. #3 Bishop


COMPANY Skelly Oil

NORTH

NE SE ~~NW~~ ^{NE}

WEST

EAST

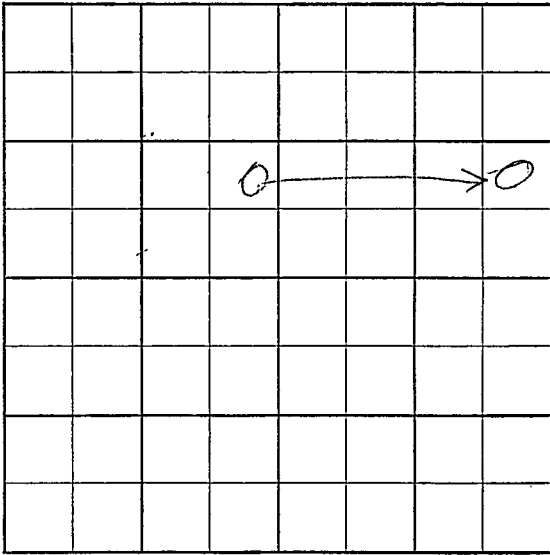

SOUTH

27

County Harper Elev. _____
Sec. 19 Twp. 31 Rgs. 6W
Company Skelly Oil
Farm Name Bishop No. 3

TOPS	DEPTH	LOG	DATUM
Anh.			
TP.			
H.			
Tr.			
Dg.			
BL.			
L.			
K.C.			
B.K.C.			
Ce.			
C.			
M.			
M.			
K.			
Mz.			
Me.			
V.			
S.			
S.			
A			
R.			
Pe.			
G.			
TD.			

Loc. in Sec. NE SE NW
Geol. _____
Contr. Wentworth
Pool Gish

	0	
SEP 18 1910		
FIRST REPORT		

Date Comm. _____
Location _____

Co.
Lse.
No.
Sec.
T.
R.

~~27~~
CORRECTION

FORM 513 SUNRAY

County Harper Elev. 1517 DF
 Sec. 19 Twp. 31 Rge. 6W
 Company Kelly Oil
 FarmName Bishop No. 3

TOPS	DEPTH	LOG	DATUM	Loc. in Sec.
Anh.				NE SE NE
Tr.				
H.				
Tr.				
Dg.				
Bl.				
L.				
K.C.	3771			Geol.
B.K.C. 3771	4060			Contr.
Ce.				Wentworth
C.				
M. <u>Li</u>	4353			Pool
M.				Gish
K.	4596			
Mz.				
Mo.				
V.				
S.	4724			
S.				
A.				
R.				
Pe.				
G.				
T.D.	4770			COMPLETE

Date Comm.

Location 9-17 - 4" 598/29
ID 2085 DLI - 27 ID 3865
DST 4354-70-60" G/3" 5u
465 mcf/5" 340 mcf/45" rec
115' 506 GCM FP 180-122 BHP
1338/20" DST 4370-90 36" G/3"
ga 530 mcf/12" rec 800 oil +
100' 5W LP 90-535 BHP 1670
cid 4725-56 full rec DST 4724-56

00:10 57

ga 240 mct

0 244 Sat 10 Boph

FEP 1110 - 1445 BHP

1805 5" 4770/150

00:23 57 CO 4753 23/4746-50

00:30 57 B 49 NWph 55 g 25 3 hrs

50 4746-50 CO 4740

24/4731-35 F10 1"chk

95 BO NW 5 hrs

36/4725-31 F10 3 3/4"chk

7.0 BO + 1 1/2 BW 6 hrs F10

160 BO NW 4 3/4"chk 6 hrs

ga 400 mct FCP 500

FEP 1000 WOP NOV - 57

Bottom Halberb

1821 BOP NW

480 g