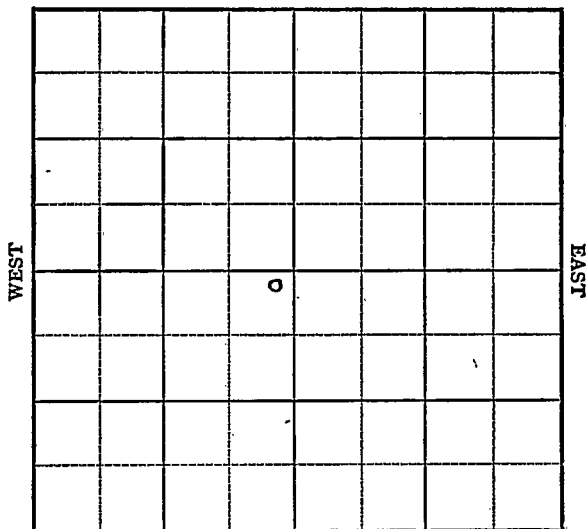


KANSAS

 StevensSection 2 Township 31 Range 37WWell No. 1 AllenCompany Hugoton Prod.Stevens
NORTH

SOUTH

KANSAS

Stevens



Sec. 2 Twp. 31 R. 37W

Well No. #1 Allen Farm

Hugoton Prod. Company


Hugoton Pool

100' Ft. from N. Line

 Ft. from S. Line

100' Ft. from E. Line

 Ft. from W. Line

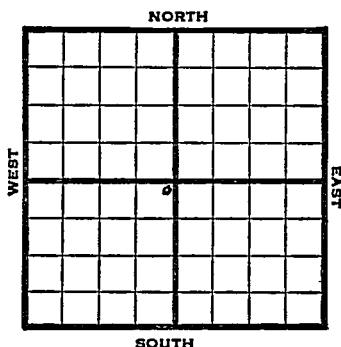

NE SW

1949 Elev 3066' REPORT

3/9 10" @ 564'

3/16 TD 2385'
7" @ 2383'

3/23 "

3/30 TD 2724'

4/6 263' of 5" Perf liner @ 2724

4/12 "

4/20 "

4/27 "

5/4 "

5/10 "

5/18 "

5/25 "

6/1 "

6/7 "

6/15 "

6/21 "

6/29 TD 2724'

7" @ 2383'

263' of 5" Perf Liner @ 2724'

7,026,000 Gas

395# R Pr.

Comp

COMPLETED

Map No. _____ Sec. 2 Twp. 31 R. 37W

Well No. 1 Allen

Hugoton Prod. Company

FIRST REPORT Contractor

NE SW


SECTION PLAT

100 Ft. from N. Line

_____ Ft. from S. Line

100 Ft. from E. Line

_____ Ft. from W. Line

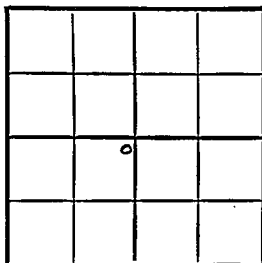

Stevens County

RECORD

Location _____

Rig up _____

Drilling and Remarks:

10" @ 564

Cased _____ in., _____ ft.

Sand _____

Gas _____

Oil _____

Total Depth _____

PRODUCTION

1st 24 hrs. Nat. _____

1st 24 hrs. after shot _____

Gas _____ Cu. Ft.

Dry Hole _____

Abandoned _____

Date

MAR 9 1949 19

S. J. LEWIS

Scout

Map No. ✓ Sec. 2 Twp. 31 R. 37W

Well No. 1 Allen

Hugoton Prod.

Company

COMPLETE

Contractor

NE SW

E 13066
SECTION PLAT

100 Ft. from N. Line

 Ft. from S. Line

100 Ft. from E. Line

 Ft. from W. Line

	6		

Stevens County

Location

Rig up

Drilling and Remarks:

7' @ 2383
263' of 5" Pex line
@ 2724
7,026,000 lbs

*325 * R/P*

RECORD

Cased in., ft.

Sand

Gas

Oil

Total Depth 2224

PRODUCTION

1st 24 hrs. Nat.

1st 24 hrs. after shot

Gas Cu. Ft.

Dry Hole

Abandoned

Date

JUN 29 1949 19

S. J. LEWIS

Scout