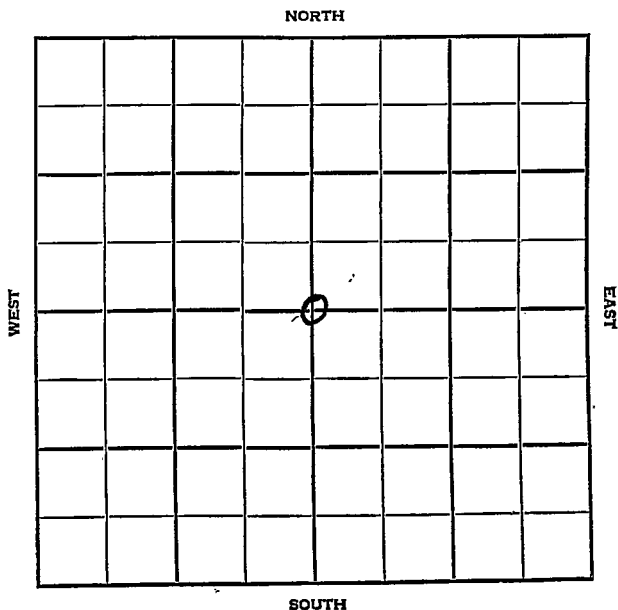


DX 78-1

Section 2 Township 31 Range 32WWell No. 1-Bird "B"Company Cities Service & Shell

Seward KANSAS


SEC.	TWP.	R.
2	31	32W
WELL NO.		
1 Bird "B"		FARM
COMPANY		
Cities Service & Shell		
CONTRACTOR		

2640 Ft. from N. Line

Ft. from S. Line

2640 Ft. from E. Line

Ft. from W. Line

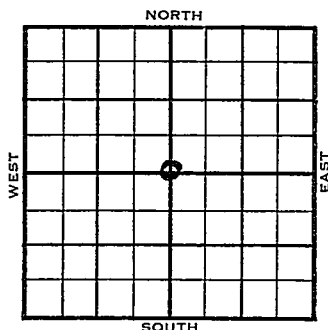

C Sec.

ELEVATION

1954


2839

REPORT

7/7 Location
 8/4 TD 2715
 8" @ 549
 Her. 2576
 Kri. 2602 Win. 2674
 TD 2715
 5" @ 2714 CO to 2696 80/2676-92
 500 A frac 2,590,000 gas SP 2655
 60/2636-48 500 A frac CO to 2692
 1,760,000 gas 1000 A 3, 550,000
 gas SP 2625 100/ 2598-2618
 60/2576-88 5000 A CO to 2691
 Comp. 7, 560,000 cfcpd 419#

COMPLETED
 COMPLETED

County Seward State Kansas
 Sec. 2 (Blk. 31) (Sur. 32W) Map No. _____
 Operator Cities Service & Shell
 Well No. 1 Farm Bird "B"
 Elev. _____ Location G Sec.

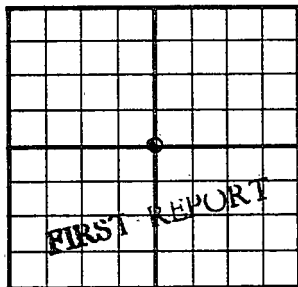

2640 Ft. From N Line Sec.

2640 Ft. From E Line Quarter

1st. Report JUL 7 1954

Completion _____

Remarks _____


Spudding Date _____

Drlg. Data _____

Location _____

J. G. McGEHEE

County Seward State Kansas
 Sec. 2 (Blk.) 31 (Sur.) 3 2W Map No.
 Operator Cities Service & Shell
 Well No. 1 Farm Bird "B"
 Elev. 2839 Location C Sec.

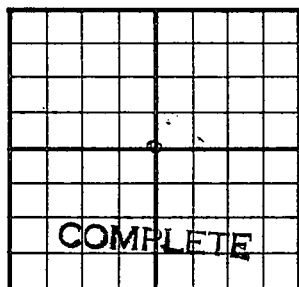

2640 Ft. From N Line Sec.
2640 Ft. From E Line Quarter
 Ist. Report
 Completion AUG 4 1954
 Remarks
 Spudding Date

Drilg. Data Gas well TD 2715
8" @ 549 Her. 2576 Kri. 2602
Win. 2674 TD 2715 5" @ 2714 CO to 2696
80/ 2676-92 500 A frac 2,590,000 gas
SP 2655 60/ 2636-48 500 A frac
CO to 2692 1,760,000 gas 1000 A
3,550,000 gas SP 2625 100/ 2598-2618
60/ 2576-88 5000 A CO to 2691
Comp. 7,560,000 cf gpd 419#

J. G. McGEHEE