

Section 2 Township 31 Range 4WWell No. #1 HyterCompany Francis Oil & Gas

NORTH

							0

WEST

EAST

SOUTH

Sumner

KANSAS

Sec. 2 Twp. 31 R. 4 W

Well No. # 1 Hyter Farm

Francis Oil & Gas

Company

Pabco

Contractor

Wildcat

330

Ft. from N. Line

Ft. from S. Line


330

Ft. from E. Line

Ft. from W. Line

NE NE NE

Atlantic F.O. Sun DHM

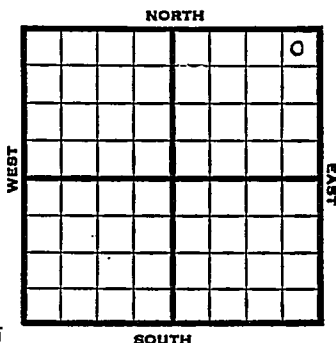

1951

Elev. 1449' REPORT

6/13

R U R

7/11

Spud 6-14-51 D & A TD 4665'
8" @ 153 Br. lime 3141' Stal 3144'
KC 3441'
DST 3549-61 open 1 hr. rec 210' SW
Miss 4072' Dol 4081' Kh. 4444'
Simp. 4526' Arb. 4640-65' TD
D & A

ABANDONED

County Sumner State KansasSec. 2 (Ek.
Twp.) + 31 (Sur.
Rge.) 4W Map No.Operator Francis Oil & GasWell No. 1 Farm HyterElev. Location NE NE NE

330 Ft. From N Line NE330 Ft. From E Line Quarter1st. Report JUN 13 1951

Completion

Remarks Pabeo - Contr.Atlantic - F. O. - Sum-DEM


Spudding Date

Drlg. Data

RURWildcat

J. E. TYRA

County Sumner State Kansas
 Sec. 2 (Blk. 31 (Sur. 4W Map No.
 (Twp.) (Rge.)
 Operator Francis Oil & Gas
 Well No. 1 Farm Hyter
 Elev. 1449 Location NE NE NE

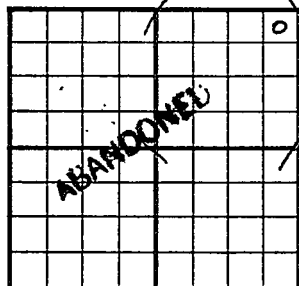

330Ft. From N Line NE
330Ft. From E Line Quarter
 Ist. Report
 Completion JUL 11, 1951
 Remarks Wildcat
Pabco Drlg. - Contr.
 Spudding Date 6-14-51

Drlg. Data D & A TD 4665
8" @ 153 Br. lime 3141 Stal. 3144
KC 3441 DST 3549-61 open 1 hr.
Rec. 210' sw Miss. 4072 Dol. 4081
Kh. 4444 Simp. 4526 Arb. 4640-65TI
D & A

J. E. TYRA