


Haprer

KANSAS

SECTION 2 TOWNSHIP 31 RANGE 9 W

WELL NO. #1 Miller

COMPANY Rupp-Ferguson

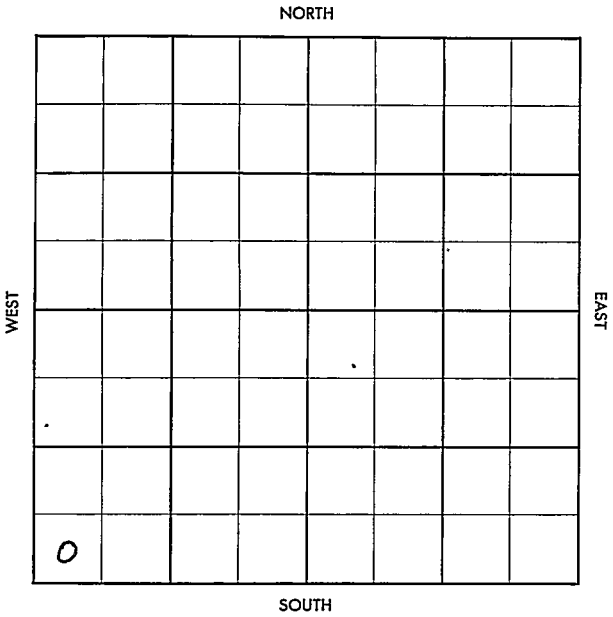

Harper

KANSAS

SEC.

TWP.

R..

2

31

9W

WELL NO.

#1 Miller

FARM

COMPANY

Rupp-Ferguson

CONTRACTOR

Co. tools

WILDCAT


Ft. from N. Line

Ft. from S. Line

Ft. from E. Line

Ft. from W. Line

SW SW SW

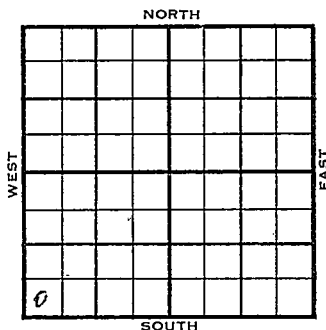

Sohio, Texas & Magnolia DHM

1955

ELEVATION

1685'

REPORT

12-7

MIR

1956

2-8

Comm. 12-7-55

8 5/8" @ 240

Ph P/ 35 BOPD / 50% water.

H. 3534

L. 3695

BKC 4214

M. 4412

TD 4530

COMPLETED

County Harper Elev. _____
 Sec. 2 Twp. 31 Rge. 9W
 Company Rupp-Ferguson
 Farm Name Miller No. 1

Co.

Lse.

No.

Sec.

T.

R.

TOPS	DEPTH	LOG	DATUM
Anb.			
Tr.			
H.			
Tr.			
Dg.			
Bl.			
L.			
K.C.			
B.K.C.			
Ce.			
C.			
M.			
M.			
K.			
Mz.			
Mq.			
V.			
S.			
S.			
A.			
R.			
Pe.			
G.			
T.D.			

Loc. in Sec. _____

SW SW SW

Geol. _____

Contr. _____

Bo. tools

Pool _____

Wildcat

FIRST REPORT

DEC 7 '55

0

Date Comm. Sohio, Texas & Magnolia - DHM
M I R

3.

Les:

No.

506.

1

2