

And

STATE CORPORATION COMMISSION OF KANSAS
OIL & GAS CONSERVATION DIVISION

WELL COMPLETION OR RECOMPLETION FORM
ACO-1 WELL HISTORY

DESCRIPTION OF WELL AND LEASE

Operator: License # 9911
Name Har-Ken Oil Company
Address 7333 E. 22nd St. #6
City/State/Zip Wichita, KS 67226

Purchaser

Operator Contact Person Donald M. Brown
Phone 316-684-1146

Contractor: License # 5380
Name Eagle Drilling, Inc.

Wellsite Geologist Stephen M. Kreidler
Phone 316-265-5370

Designate Type of Completion

- New Well
- Re-Entry
- Workover
- Oil
- Gas
- Dry
- SWD
- Inj
- Other (Core, Water Supply etc.)
- Temp. Abd.
- Delayed Comp.

If **OWNO**: old well info as follows:

Operator
Well Name
Comp. Date Old Total Depth.....

WELL HISTORY

Drilling Method:
 Mud Rotary Air Rotary Cable

4/22/85 5/2/85 5/3/85
.....
Spud Date Date Reached TD Completion Date


5302
.....
Total Depth PBTD

Amount of Surface Pipe Set and Cemented at 630 feet
Multiple Stage Cementing Collar Used? Yes No
If yes, show depth set.....feet
If alternate 2 completion, cement circulated
from.....feet depth to.....w/.....SX cmt

API NO. 15-033-20676
County Comanche
C. SE SE Sec 33 Twp 31 Rge 20 East West
740 Ft North from Southeast Corner of Section
670 Ft West from Southeast Corner of Section
(Note: Locate well in section plat below)

Lease Name Tobias Well # 1
Field Name Wildcat
Producing Formation Dry
Elevation: Ground 1940 KB 1953

Section Plat

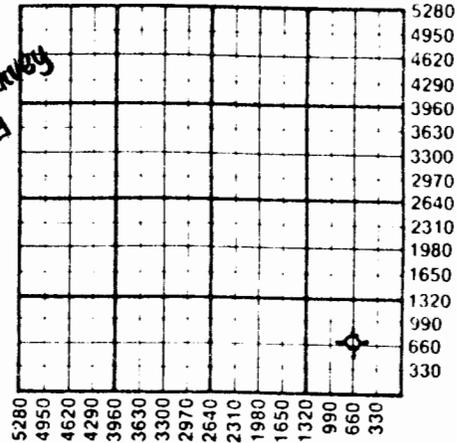

RECEIVED
STATE CORPORATION COMMISSION
WICHITA, KANSAS
JUN 1 1 1985
Geological Survey
BRANCH

WATER SUPPLY INFORMATION

Disposition of Produced Water: Disposal Repressuring
Docket #

Questions on this portion of the ACO-1 call:
Water Resources Board (913) 296-3717

Source of Water:
Division of Water Resources Permit #.....

Groundwater.....Ft North from Southeast Corner
(Well)Ft West from Southeast Corner of
Sec Twp Rge East West

Surface Water.....Ft North from Southeast Corner
(Stream, pond etc).....Ft West from Southeast Corner
Sec Twp Rge East West

Other (explain) Stream on property.
(purchased from city, R.W.D. #)

INSTRUCTIONS: This form shall be completed in duplicate and filed with the Kansas Corporation Commission, 200 Colorado Derby Building, Wichita, Kansas 67202, within 90 days after completion or recompletion of any well. Rule 82-3-130 and 82-3-107 apply.
Information on side two of this form will be held confidential for a period of 12 months if requested in writing and submitted with the form. See rule 82-3-107 for confidentiality in excess of 12 months.
One copy of all wireline logs and drillers time log shall be attached with this form. Submit CP-4 form with all plugged wells. Submit CP-111 form with all temporarily abandoned wells.