


Section 20 Township 31 Range 12 W

Well No. # 1 Callaway

Company Beardmore et al

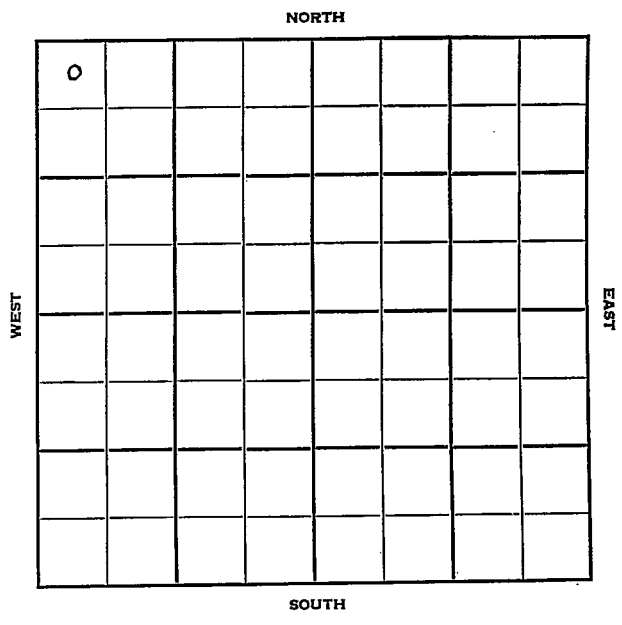

Sec. 20 Twp. 31 R. 12 W

Well No. # 1 Callaway Farm

Beardmore et al Company

Contractor

Wildcat

330 Ft. from N. Line


Ft. from S. Line

Ft. from E. Line

330 Ft. from W. Line

NW NW NW

Mid-States farmout

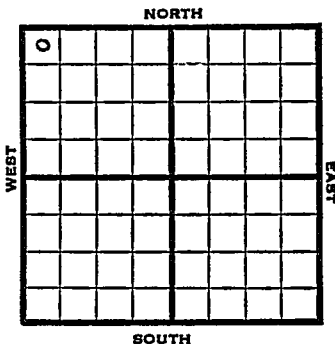

1951 Elev. 1619' REPORT

3/28 R U R

4/25 Spud 4-1-51  
 D&A TD 4663  
 8" @ 146  
 Heeb. 3404 Lans. 3704  
 Miss 4200 Kinderhook 4311  
 Viola 4418  
 DST 4370-4407 opn 45 min. Rec. 10'  
 mud  
 Simp 4497  
 DST 4496-4509 opn 15 min.  
 Rec. 15' mud Simp 4504 Arb. 4609  
 TD 4663' D&A

**ABANDONED**

County **Barber** State **Kansas**

Sec. **20** (Blk. Twp.) **31** (Sur. Rge.) **12W** Map No.

Operator **Beardmore etal.**

Well No. **1** Farm **Callaway**

Elev. \_\_\_\_\_ Location **NW NW NW**

0							

**330** Ft. From **N** Line **NW**

**330** Ft. From **W** Line **Quarter**

1st. Report **MAR 28 1951**

Completion \_\_\_\_\_

Remarks **Mid-States farmout**

Spudding Date \_\_\_\_\_

Drig. Data **Wildcat**

**R U R**

County Barber State Kansas

Sec. 20 (Blk. Twp.) 31 (Sur. Rge.) 12W Map No.

Operator Beardmore et al.

Well No. 1 Farm Callaway

Elev. 1619 Location NW NW NW

0							

330 Ft. From N Line NW

330 Ft. From W Line Quarter

Ist. Report

Completion APR 25 1951

Remarks Wildcat

Spudding Date 4-1-51

Drlg. Data D & A TD 4663

8" @ 146 Heeb. 3404 Lans. 3704

Miss. 4200 Kinderhook 4311 Viola 4418

DST 4370-4407 open 45 min. Rec. 10' mud

Simp. 4497 DST 4496-4509 open 15 min.

Rec. 15' mud Simp. 4504 Arb. 4609

TD 4663 D & A

J. E. TYRA